


Water Service Tie Card
TOWN OF LEXINGTON
 MASSACHUSETTS

137 Grant Street

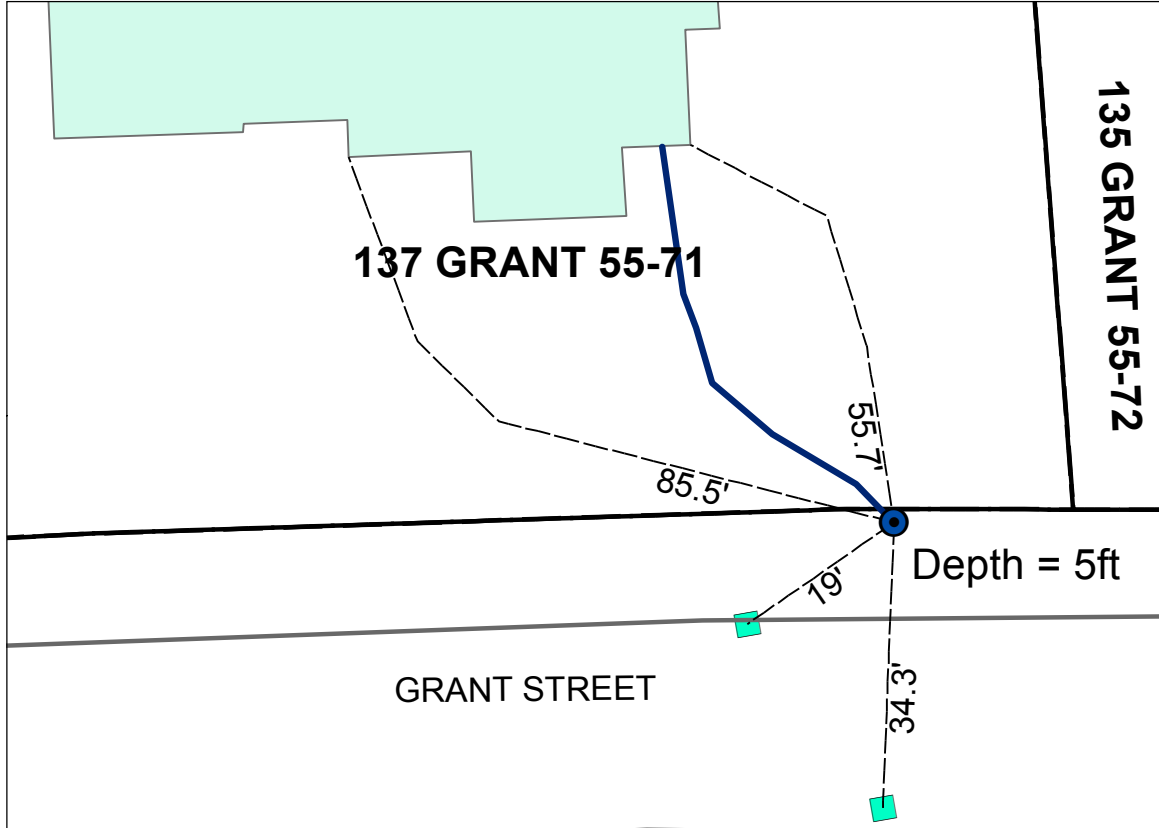

Address	Map and Lot	Permit Number	Contractor Name	Inspector
137 Grant Street	55-71	5373	H. Rice & Sons	D. Pavlik

Date: 10/3/2013	Material	Amount
	3/4" Copper	6 inches off of existing curb stop
	1" x 3/4" fitting	
	1" Copper	6 inches to 1" curb stop
	1" Curb Stop	
	1" Copper type "k"	58 Feet

Type of work completed
 New 1" water service to house from curb stop. New house built - old house removed on existing lot.