


DATE 7.97

TOWN OF LEXINGTON — BOARD OF PUBLIC WORKS
WATER DIVISION

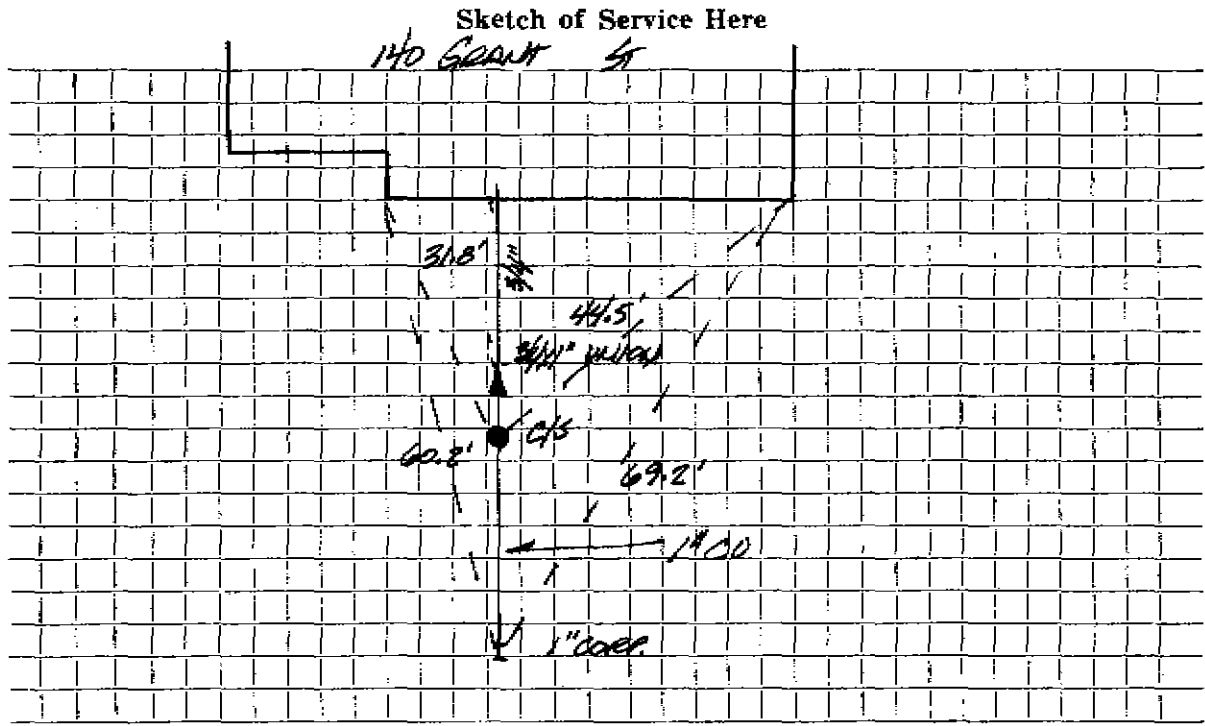

Connection made in GRANT Street.

Work completed CONTRACT 962

Remarks:

.....

.....