

WATER SERVICE RECORD

Name

Service No.

Address

141 GRANT STREET

Location

Repair—Renewal—New Service


Date	Material	Amount	Total	Date	Amount
12-14-51	LABOR	2.98	2.98	7-97	
	10% OH	30	30	27	LF 1" COPPER
	50 LF 1" COPPER		20.24	1	1" CORROSION
	1 1"X1" 1/4" SW		5.12	1	1" C/S 4/6 BOX
	1 1"X1" UNION		2.20	1	1" UNION
	2 HR SHOVEL		14.00		
	1 HR TRUCK		75		
	4X3 PATCH		4.00		
			<u>49.65</u>		
	PAID 12-4-51				

DATE 7.97

TOWN OF LEXINGTON — BOARD OF PUBLIC WORKS

WATER DIVISION

Sketch of Service Here

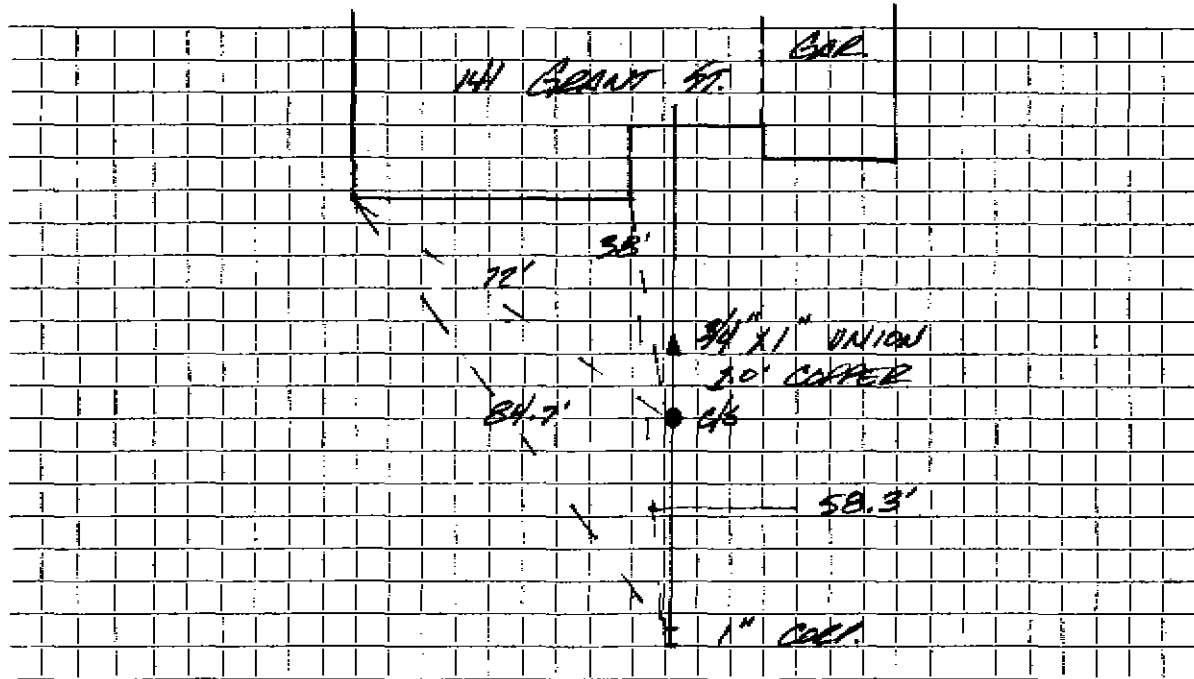

Connection made in GRANT Street.

Work completed CONTRACT 96-2

Remarks:
.....
.....