

WATER SERVICE RECORD

Name

Service No.

Address 142 GRANT STREET

Location


Repair Renewal New Service

Date	Material	Amount	Total	Date	Material	Amount
4.3.46	LABOR	25.03	25.03	7.97		
	10% ON		2.50	37	LF 1" COPPER	
36	LF 3/4" COPPER		6.88	1	1" C/S W/B. BOX	
1	3/4" x 3/4" UNION STD		2.59	1	1" CONNECTION	
1	HR TRUCK		.15	1	1" x 3/4" UNION	
			37.75			
	PAID 4.11.46					

DATE 7.97

TOWN OF LEXINGTON — BOARD OF PUBLIC WORKS

WATER DIVISION

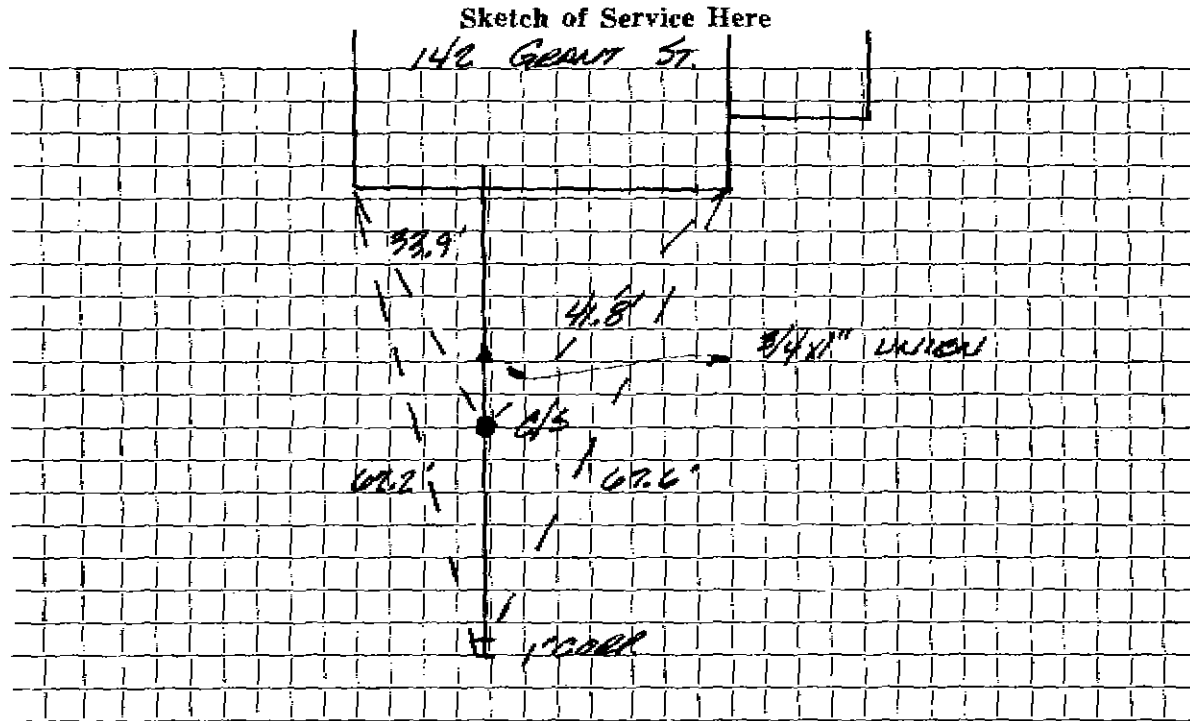

Connection made in GRANT Street. Work completed CONTRACT 96-2

Remarks:

.....

.....