


DATE 7-97

TOWN OF LEXINGTON — BOARD OF PUBLIC WORKS
WATER DIVISION

Sketch of Service Here

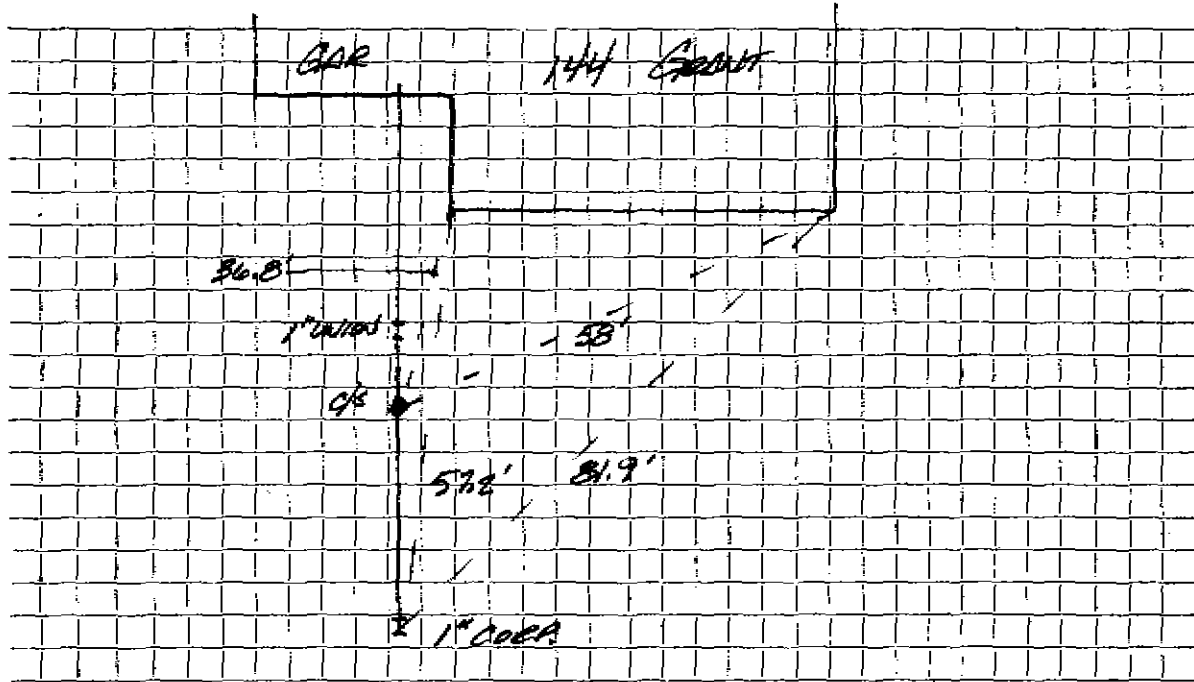

Connection made in GRANT Street. Work completed CONTRACT 96-2

Remarks:

.....

.....