

WATER SERVICE RECORD

Name

Service No.

Address 145 GRANT STREET

Location


Repair—Renewal—New Service

Date	Material	Amount	Total	Date	Amount
9.22.51	LABOR	5 96	5 96	7.97	
	10% OH		60		
	45 LF COPPER - 3/4"		14 67	20 LF 1" COPPER	
	1 3/4" x 1/2" UNION STD		4 00	1 1" CORPORATION	
	1 SHOVEL		7 00	1 1" x 3/4" UNION	
	1 HR TRUCK		15	1 1" CB W/B. BOX	
	9 X 3 PATCH		9 00		
			41 96		
	PAID 7.20.51				

DATE 7.97

TOWN OF LEXINGTON — BOARD OF PUBLIC WORKS

WATER DIVISION

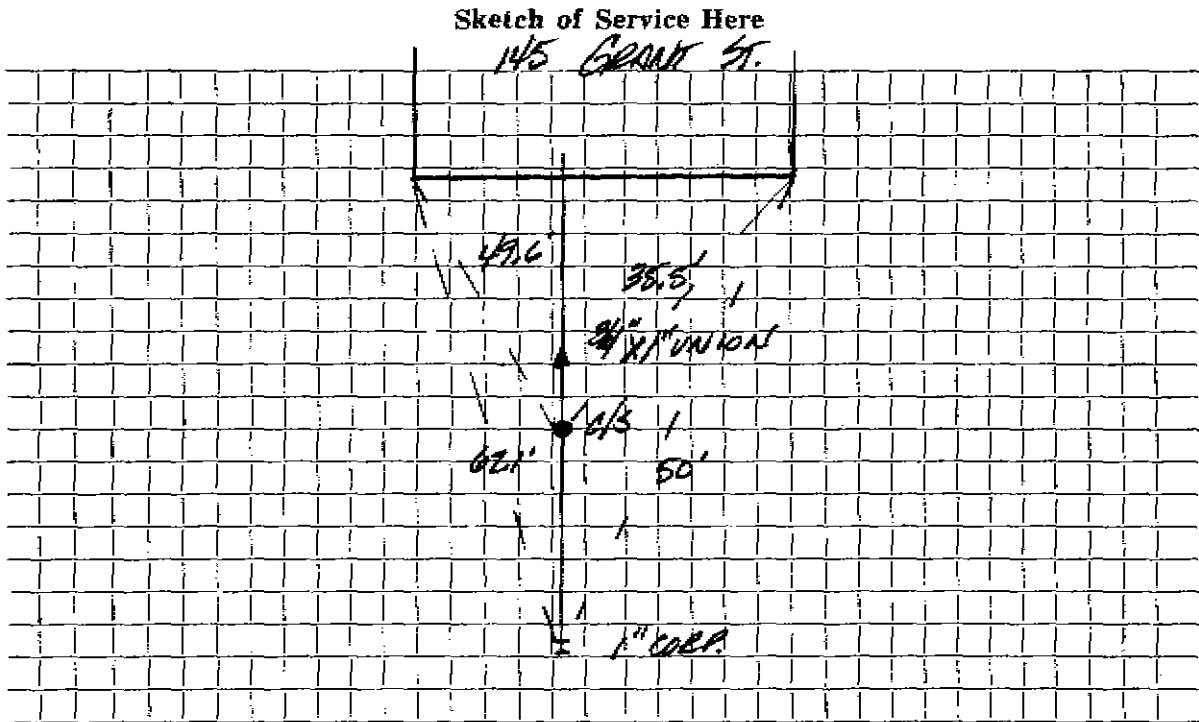

Connection made in GRANT Street. Work completed Contract No. 2

Remarks:
.....
.....