

WATER SERVICE RECORD

Name

Service No.

Address 150 GRANT STREET

Location


Repair—Renewal—New Service

Date	Material	Amount	Total	Date	Material	Amount
9.15.53	LABOR	14 24		7.97		
	10% OH	1 42	15.66	95	LF 1" COPPER	
111	LF 3/4" COPPER		40.28	1	1" CORPORATION	
1	3/4" x 1/2" IRON SAND		4.00	1	1" x 3/4" UNION	
2	3/4" x 3/4" UNIONS		3.44	1	CURB STOP / W/ B. BOX	
4	HES SHOVEL		30.00			
1	HR TRUCKING		.75			
21	x3 PATCH		21.00			
			115.13			
	PAID 8.24.53					

DATE 7.97

TOWN OF LEXINGTON — BOARD OF PUBLIC WORKS

WATER DIVISION

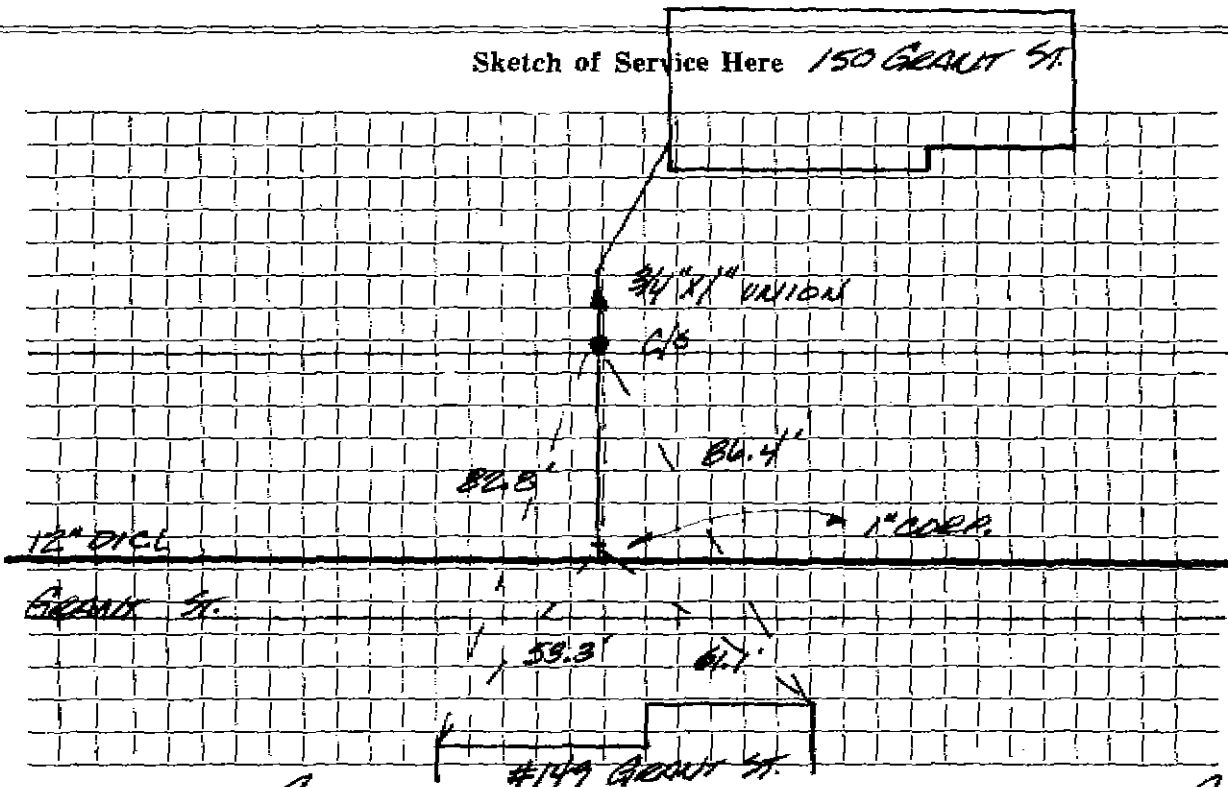

Connection made in GRANT Street. Work completed CONTRACT 96-2

Remarks: .....