

WATER SERVICE RECORD

Name

Service No.

Address 153 GRANT STREET


Location

Repair—Renewal—New Service

Date	Material	Amount	Total	Date	Amount
11-20-47	LABOR	1.05	1.05	7.97	
	10% OH		.11	25 LF 1" COPPER	
	37 LF 3/4" COPPER		9.99	1 1" COPPERATION	
	1 3/4 x 1/2" IRON SHVL.		3.15	1 1 1/4 UNIONS	
	2 SHOVEL (HRS)		14.00	1 1" C/S W/E. BOX	
	1 HR TRUCK		.75		
	9x3 PATCH		9.00		
			38.05		
	PAID 11.25.47				

DATE 7.97

TOWN OF LEXINGTON — BOARD OF PUBLIC WORKS
WATER DIVISION

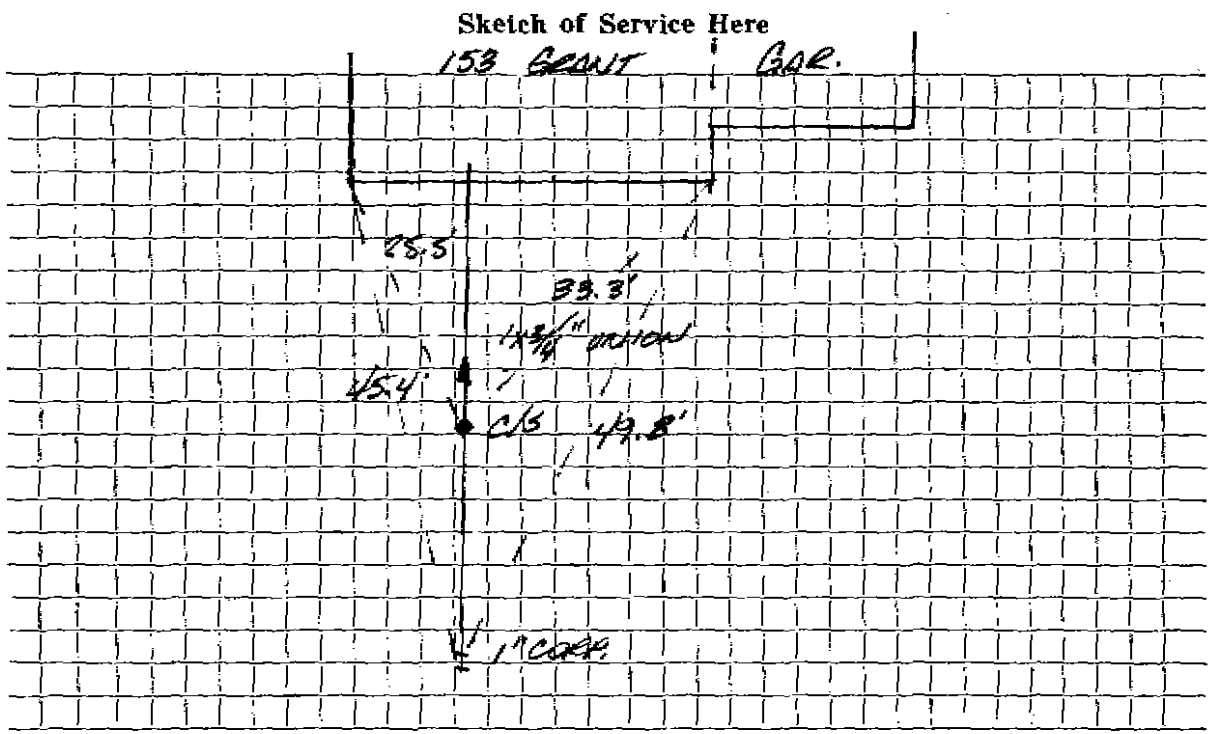

Connection made in GRANT Street.

Work completed CONTRACT 96-2

Remarks:

.....

.....