

WATER SERVICE RECORD

Name

Service No.

Address 154 GRANT STREET

Location


Repair—~~Renewal~~—New Service

Date	Material	Amount	Total	Date	Amount
5.17.57	LABOR			7.97	
	10% ON				
47	LF 3/4" COPPER			32	LF 1" COPPER
1	3/4" x 1/2" IWA STD			1	3/4 x 1" UNION
1	3/4" UNION			1	1" C/S W/B.BOX
1	HR TRUCK			1	1" COPPERATION
	PAID 4.1.57				

DATE 7-97

TOWN OF LEXINGTON — BOARD OF PUBLIC WORKS  
WATER DIVISION

Sketch of Service Here

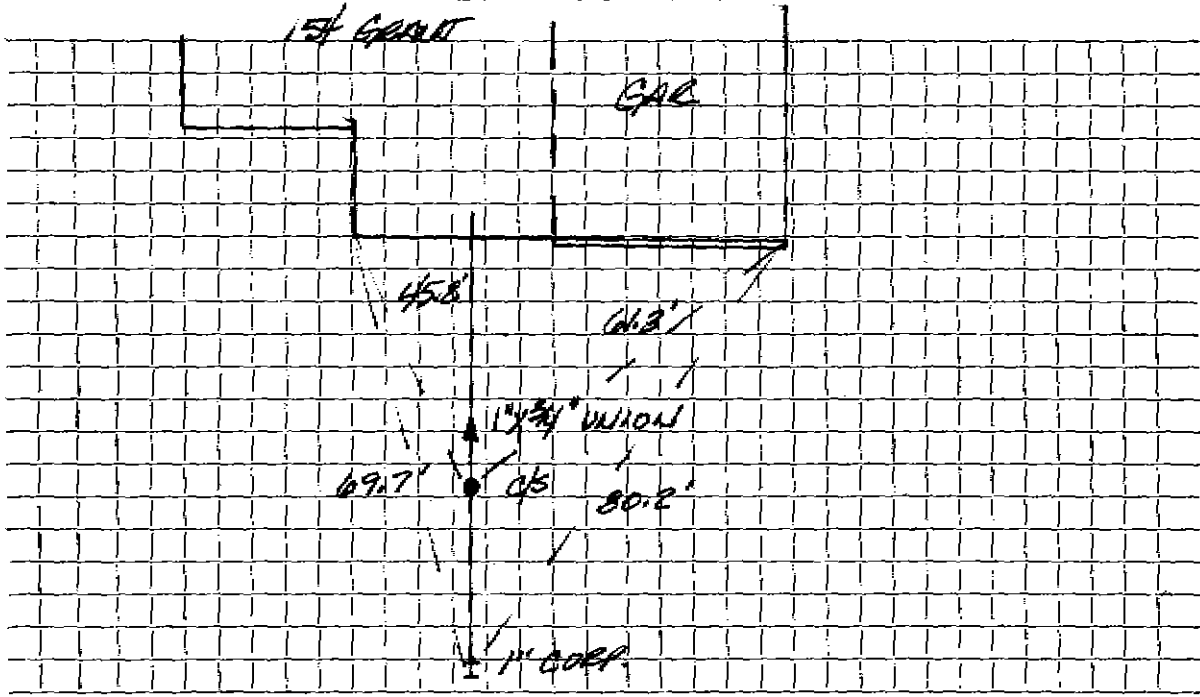

Connection made in ..... GRANT Street.

Work completed ..... CONTRACT 96-2

Remarks: .....  
.....  
.....