


DATE 9-24-09

TOWN OF LEXINGTON — BOARD OF PUBLIC WORKS

WATER DIVISION

Sketch of Service Here

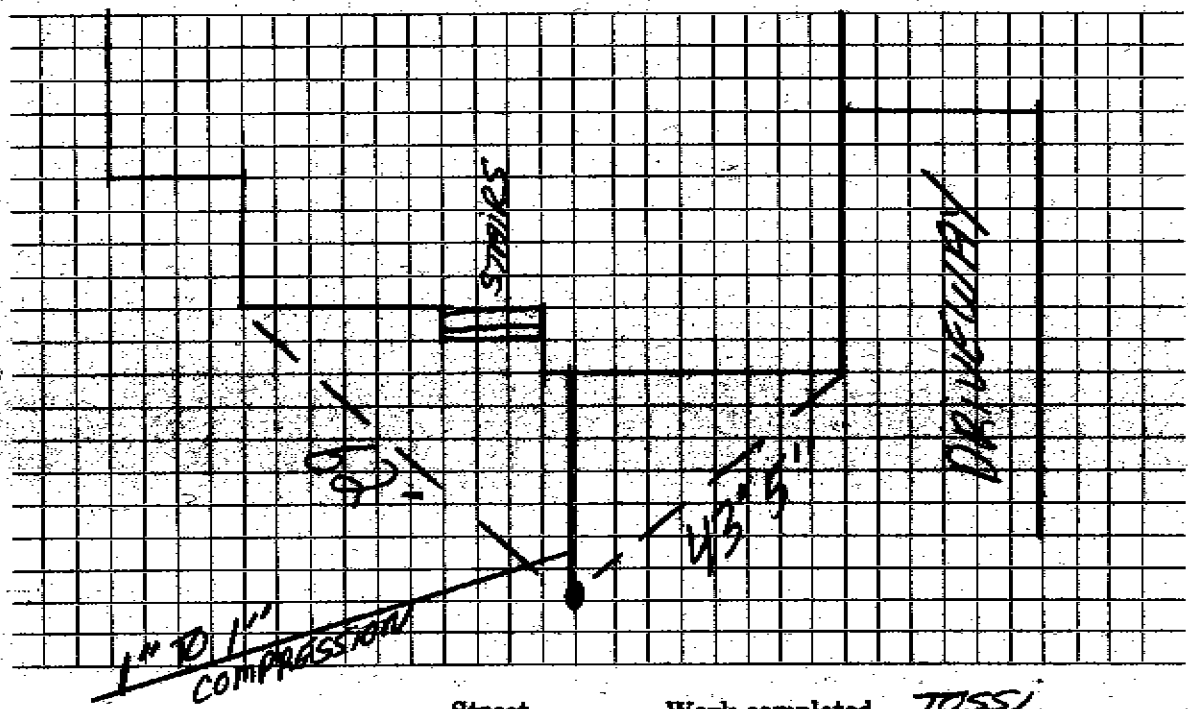

Connection made in Street. Work completed TOSSI

Remarks:
.....
.....