

WATER SERVICE RECORD

Name

Service No.

Address 161 GRANT STREET

Location


Repair Renewal New Service

Date	Material	Amount	Total	Date	Material	Amount
8.7.67	LABOR	4.33		7.97		
	10% OH	.43	4.76	22	LF 1" COPPER	
	60 LF 1" COPPER	.56	53.60	1	<del>1" x 3/4"</del> 1" UNION	
	1 1" x 3/4" WLL SWI		6.96	1	1" CORPORATION	
			45.32	1	1" C/S 1/2 B. BOX	

DATE 7-97

TOWN OF LEXINGTON — BOARD OF PUBLIC WORKS  
WATER DIVISION

Sketch of Service Here

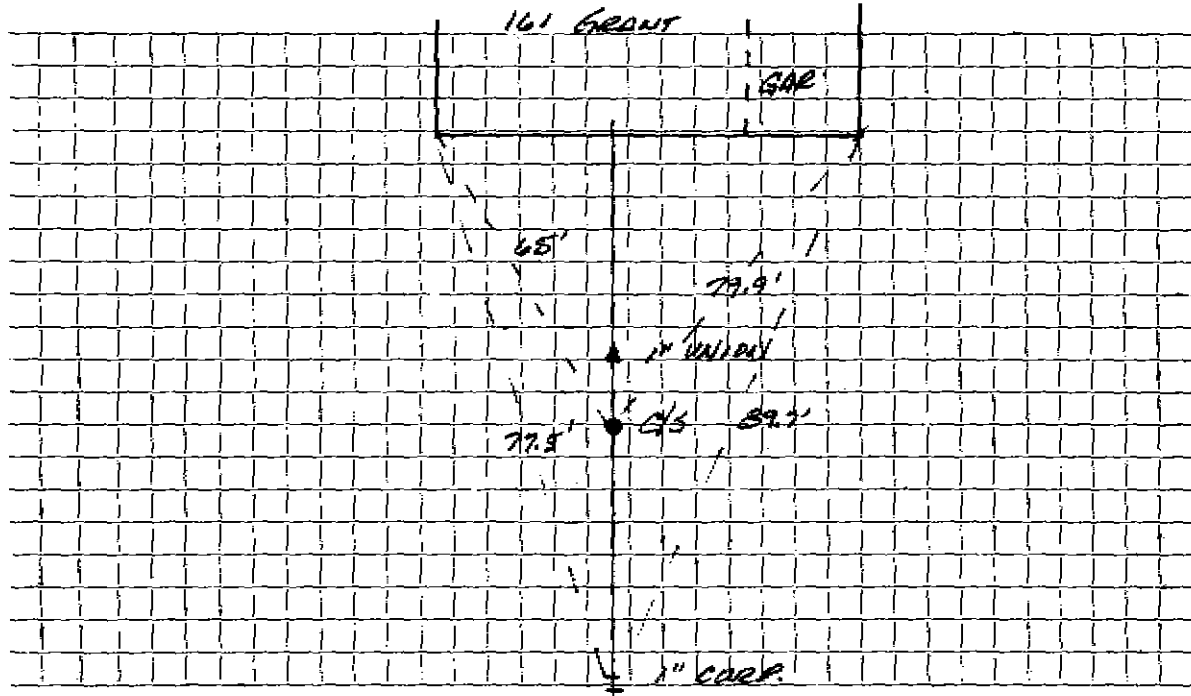

Connection made in ..... GRANT Street. Work completed ..... CONTRACT 96-2

Remarks: .....  
.....  
.....