


DATE _____

TOWN OF LEXINGTON — BOARD OF PUBLIC WORKS

WATER DIVISION

Sketch of Service Here

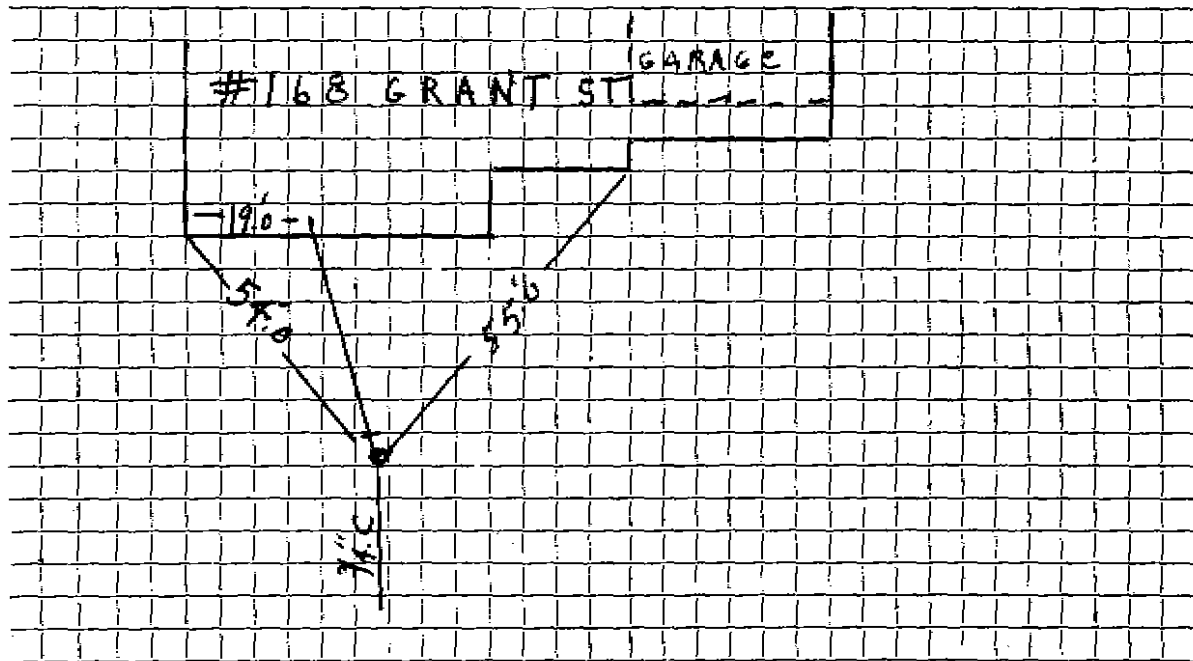

Connection made in Street. Work completed 10/27/04

Remarks:

.....

.....

WATER SERVICE RECORD

Name

Service No.

Address 168 GRANT STREET

Location


Repair ~~Renewal~~ New Service

Date	Material	Amount	Total	Date	Amount
3-28-57	LABOR	1.85		7-77	
	10% OH	.19	2.04	29	LF 1" COPPER
	35 LF 3/4" COPPER	.4028	14.80		1 1" CORPORATION
	1 3/4" x 1/2" 1214 SW.		4.96		1 1" x 3/4" UNION
			<u>21.80</u>		1 1" C/S W/ BUFFALO BOX
	PAID				
	6-10-57				

DATE 7-97

TOWN OF LEXINGTON — BOARD OF PUBLIC WORKS
WATER DIVISION

Sketch of Service Here

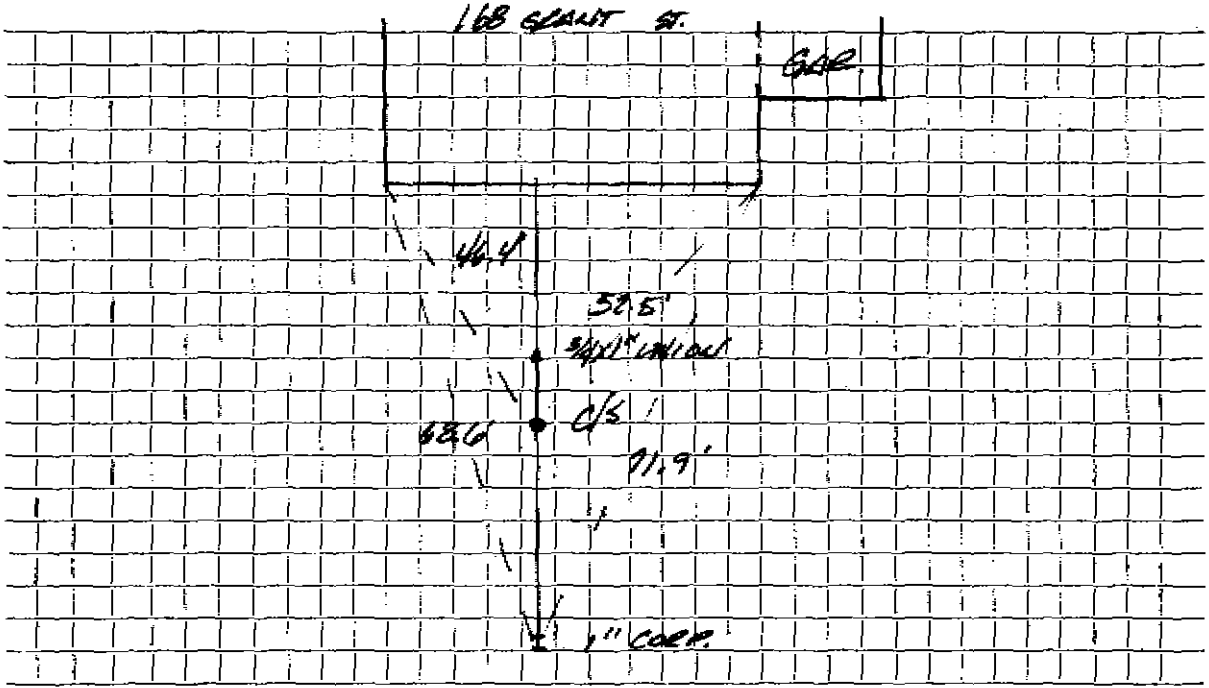

Connection made in Grant Street. Work completed CONTRACT 96-2

Remarks:
.....
.....