

WATER SERVICE RECORD

Name

Service No.

Address 180 GRANT STREET

Location


Repair—Renewal—New Service

Date	Material	Amount	Total	Date	Material	Amount
4.9.54	LABOR	8.00		7.97		
	10% OH	.80	8.80		35 LF 1" COPPER	
	60 LF 3/4" COPPER	.36	21.00		1 1" CORPORATION	
	1 3/4 x 1/2 INCH SPI		4.00		1 C/S w/ BUFFALO BOX	
	1 HR SHOVEL		7.50		1 1" x 3/4 UNION	
	1 HR TRUCKING		.75			
	20 X3 PATCH		20.00			
			<u>62.05</u>			
	PAID 5.3.54					

DATE 7.97

TOWN OF LEXINGTON — BOARD OF PUBLIC WORKS  
WATER DIVISION

Sketch of Service Here

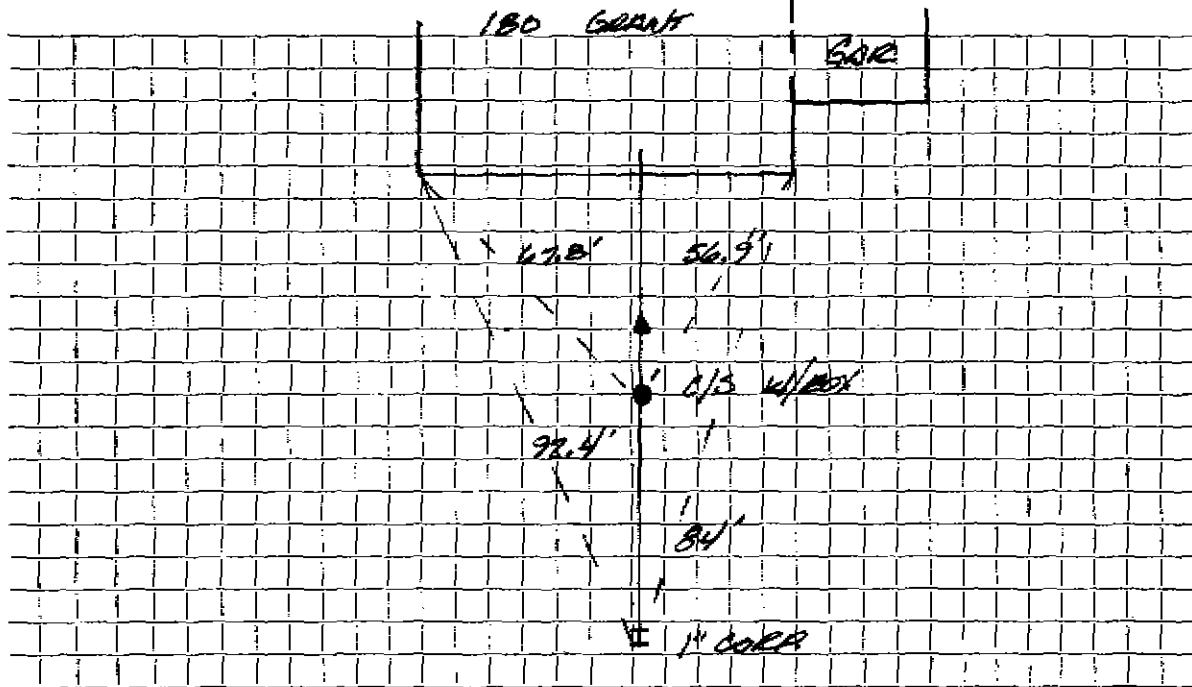

Connection made in ..... GRANT Street.

Work completed ..... CONTRACT 96-2

Remarks: .....

.....

.....