

WATER SERVICE RECORD

Name

Service No.

Address 181 GRANT STREET

Location

Repair—Renewal—New Service


Date	Material	Amount	Total	Date	Material	Amount
8-7-61	LABOR	32.86		7-97		
	10% OH	3.29	36.15		18 LF 1" COPPER	
59	3/4" COPPER	.42	24.78		1 1" COPPER UNION	
1	3/4x1/2" W/4 SWJ		6.17		1 1" C/S W/3 BOX	
1 1/2	HR SHOVEL		9.75		1 1" x 3/4" UNION	
1 1/2	HR TRUCKING		4.50			
	10 X3 PATCH		10.00			
			<u>91.35</u>			
	PAID					
	9-25-61					

DATE 7.97

TOWN OF LEXINGTON — BOARD OF PUBLIC WORKS

WATER DIVISION

Sketch of Service Here

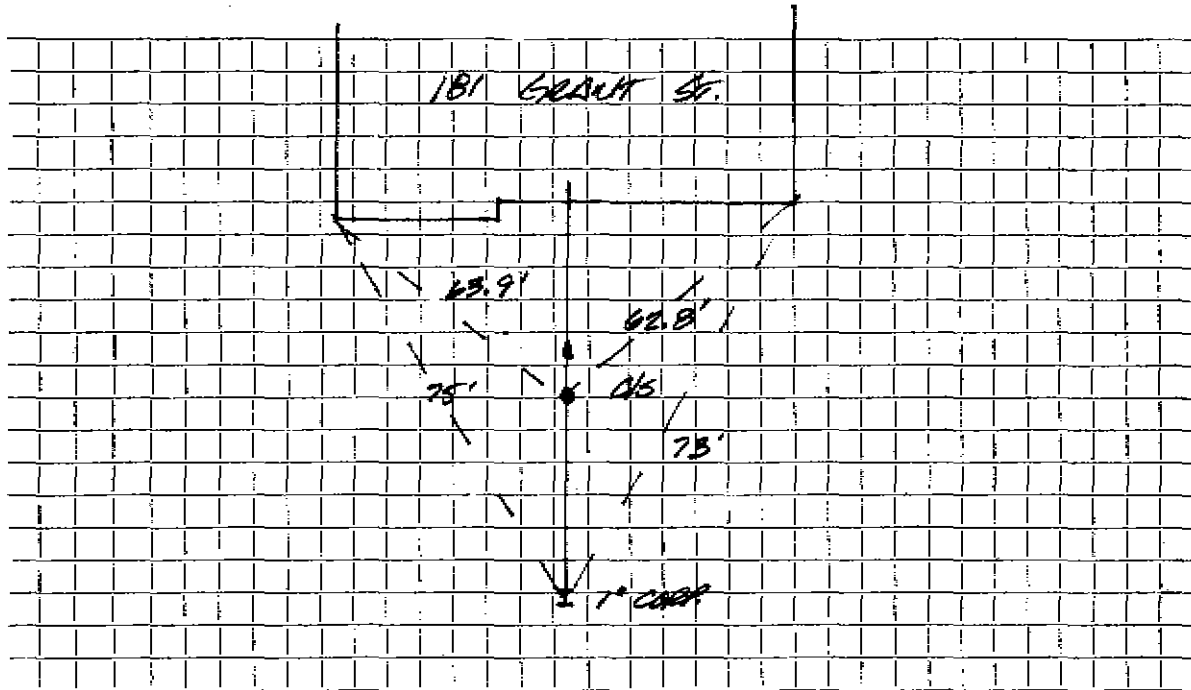

Connection made in GRANT Street.

Work completed CONTRACT 96-2

Remarks:
.....
.....