

WATER SERVICE RECORD

Name

Service No.

Address *185 GRANT STREET*

Location


Repair—Renewal—New Service

Date	Material	Amount	Total	Date	Amount
<i>8.1.61</i>	<i>60 3/4" COPPER</i>			<i>7.97</i>	
	<i>1 3/4 X 1/2" 12 1/2" SWG</i>			<i>21 LF 1" COPPER</i>	
	<i>5 X 3 PATCH</i>			<i>1 1" CORROSION</i>	
				<i>1 1" C/S W/B. BOX</i>	
				<i>1 1" X 3/4" UNION</i>	

DATE 7.97

TOWN OF LEXINGTON — BOARD OF PUBLIC WORKS
WATER DIVISION

Sketch of Service Here

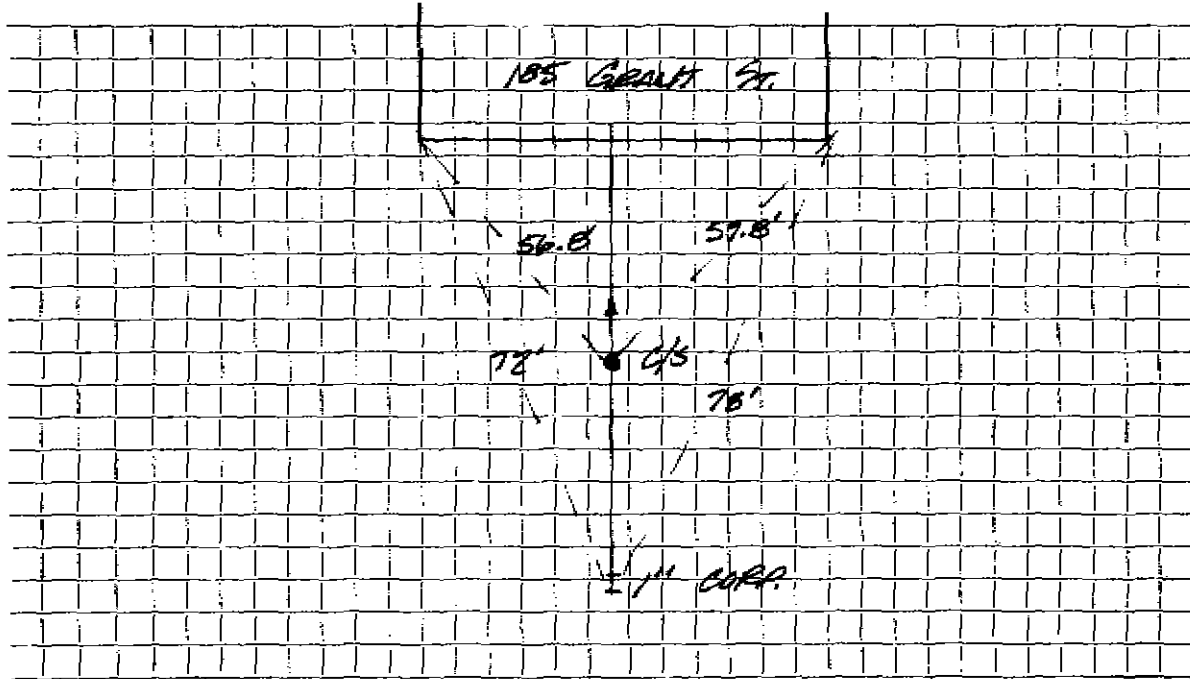

Connection made in GRANT Street.

Work completed CONTRACT 96-2

Remarks:
.....
.....