


DATE _____

TOWN OF LEXINGTON — BOARD OF PUBLIC WORKS
WATER DIVISION

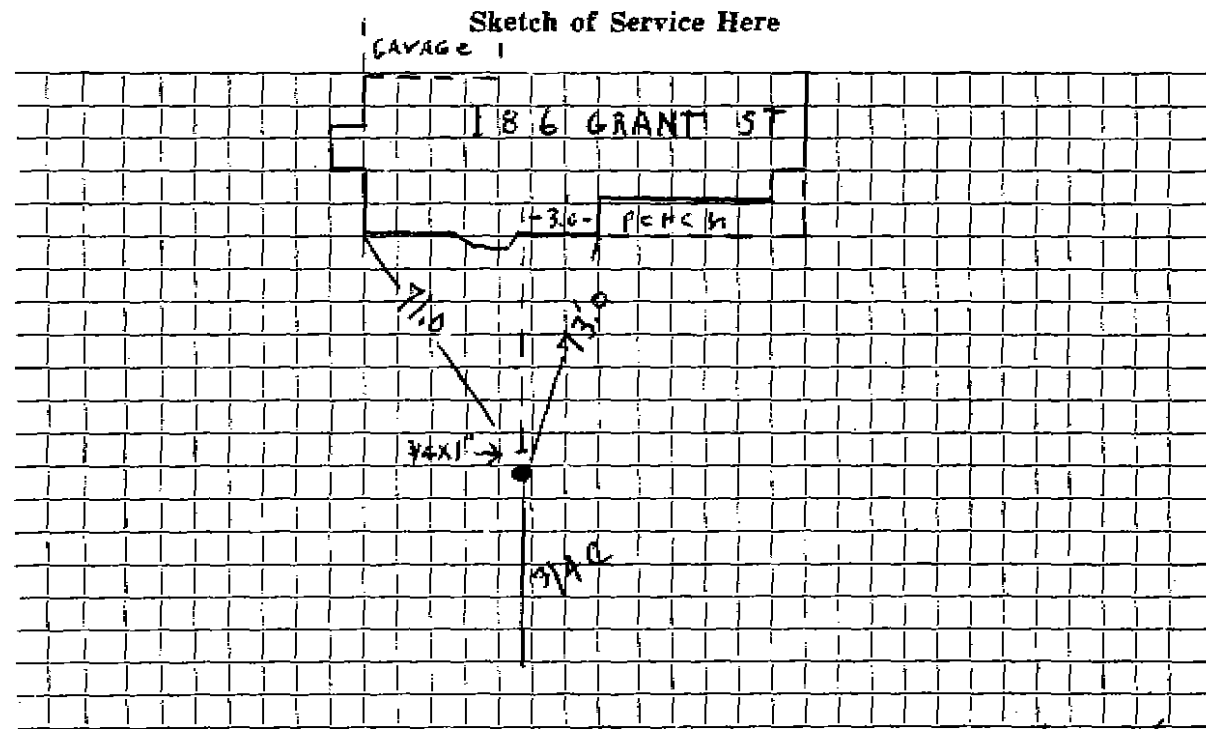

Connection made in Street.

Work completed 10/20/07 J. Mcle

Remarks:

.....


.....

DATE 7.97

TOWN OF LEXINGTON — BOARD OF PUBLIC WORKS

WATER DIVISION

Sketch of Service Here

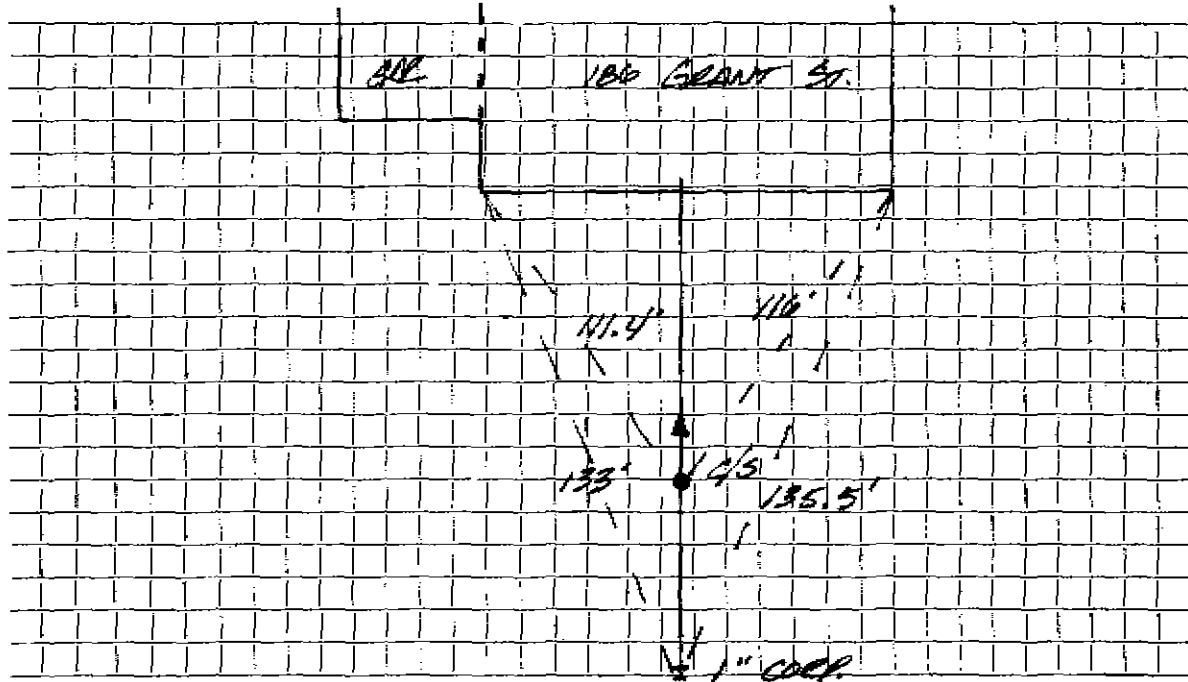

Connection made in GRANT Street. Work completed CONTRACT 96-2

Remarks:
.....
.....