

WATER SERVICE RECORD

Name

Service No.

Address *193 GRANT STREET*

Location

Repair - Renewal - New Service


| Date | Material | Amount | Total | Date | Material | Amount |
|----------------|-----------------------------|--------|-------|-------------|-------------------------|--------|
| <i>11.2.04</i> | <i>71 LB 3/4" COPPER</i> | | | <i>7.97</i> | <i>18 LB 1" COPPER</i> | |
| | <i>1 3/4 x 1/2" W/H SWJ</i> | | | | <i>1 1" CORROSION</i> | |
| | <i>1 3/4 UNION</i> | | | | <i>1 1" 3/4" UNION</i> | |
| | <i>6x3 PATCH</i> | | | | <i>1 1" G/S W/B BOX</i> | |

DATE 7.97

TOWN OF LEXINGTON — BOARD OF PUBLIC WORKS

WATER DIVISION

Sketch of Service Here

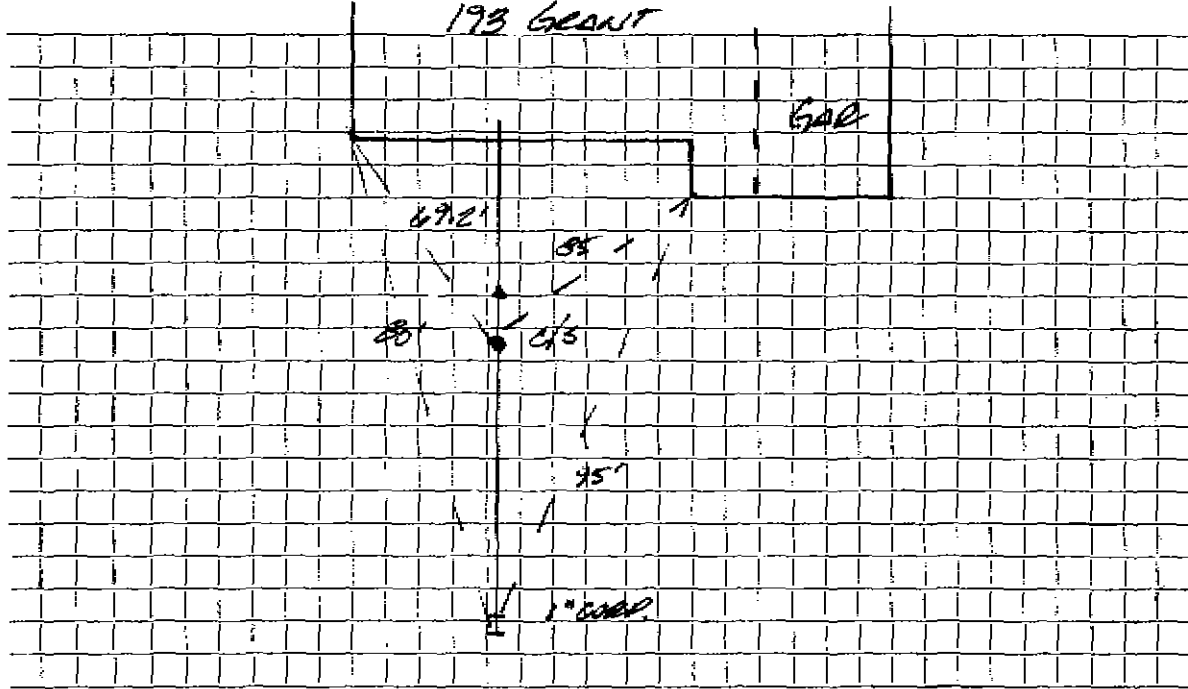

Connection made in GRANT Street.

Work completed CONTRACT 96-2

Remarks:

.....

.....