

WATER SERVICE RECORD

Name

Service No.

Address

Location 194 GRANT ST

Repair—Renewal—New Service REDMOND CONT


Date	Material	Amount	Total	Date	Amount
6/9/86					
12/8/86	77.4 1" COPPER 1" VALVE		6/	6/9/86	40' 1" COPPER 1" CURB 1" BOX & ROD
				1996	NEW 1" COPP USED EXIST COPPER

DATE \_\_\_\_\_

TOWN OF LEXINGTON — BOARD OF PUBLIC WORKS

WATER DIVISION

Sketch of Service Here

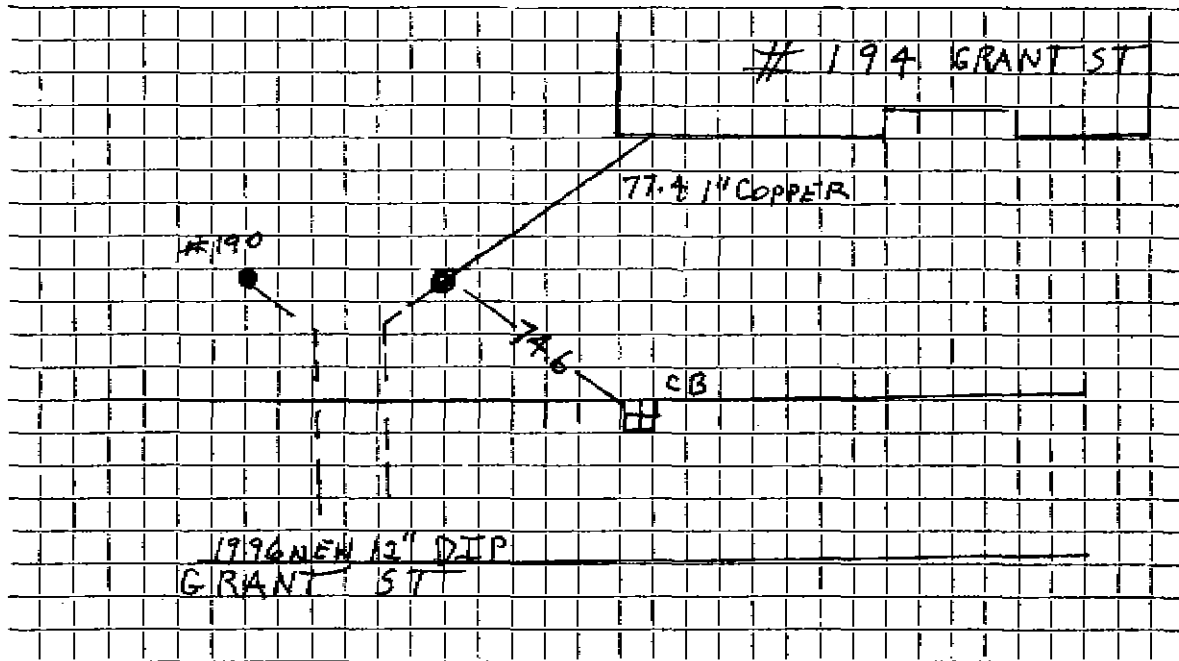

Connection made in ..... Street. Work completed .....

Remarks: "SERVICE FOR 190 AND 194 IN SAME TRENCH" IN ST. ....