


DATE 8-16-01

TOWN OF LEXINGTON — BOARD OF PUBLIC WORKS

WATER DIVISION

Sketch of Service Here

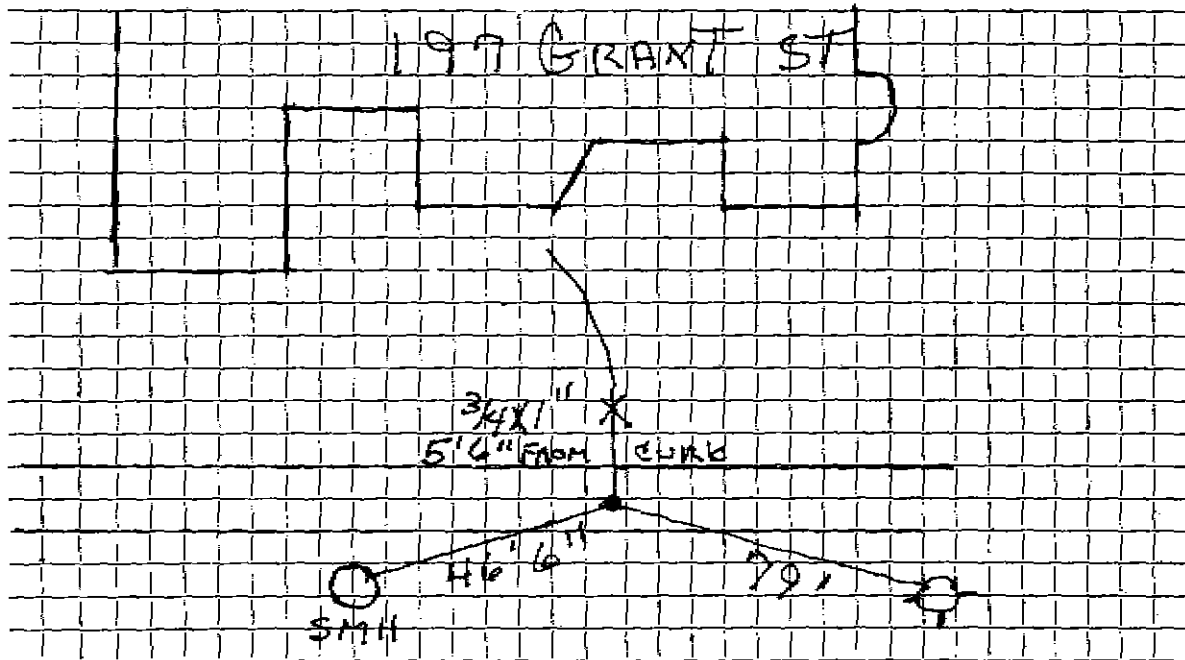

Connection made in Street. Work completed

Remarks:

.....

.....

3951

WATER SERVICE RECORD

Name Robert Campbell

Service No. 200

Address 197 Grant Street

Location

Repair ~~Other~~ New Service


Comm 12-31-61

Date	Material	Amount	Total	Date	Material	Amount
12/7/61	Labor	6 20		12-7-61	Deposit	35 00
	10% O.H.	62	6 82	12-31-61	Refund	16 01
	Owners Copper					18 99
	1 3/4" Cx 1/2" IWH Stop & Waste		6 17			
	1 Hr. Trucking @ 3.00		3 00			
	3 X 3 Patch		3 00	12/7/61	Labor	25 99
			18 99		6' 3/4" Copper Tubing @ .42	2 52
					1 3/4" C Corp Cock	4 91
					1 3/4" C Curb Cock	6 28
					1 Box & Rod	4 90
					1 1/2" Straight Tailpiece	50
					1 1/2" Offset Tailpiece	50
					1 Hr. Town Shovel @ 5.00	5 00
						50 60
				7.97	18 LF 1" COPPER	
					1 1" CORPORATION	
					1 1" x 3/4" UNION	
					1 1" C/S w/B. BOX	

DATE 7.97

TOWN OF LEXINGTON — BOARD OF PUBLIC WORKS
WATER DIVISION

Sketch of Service Here

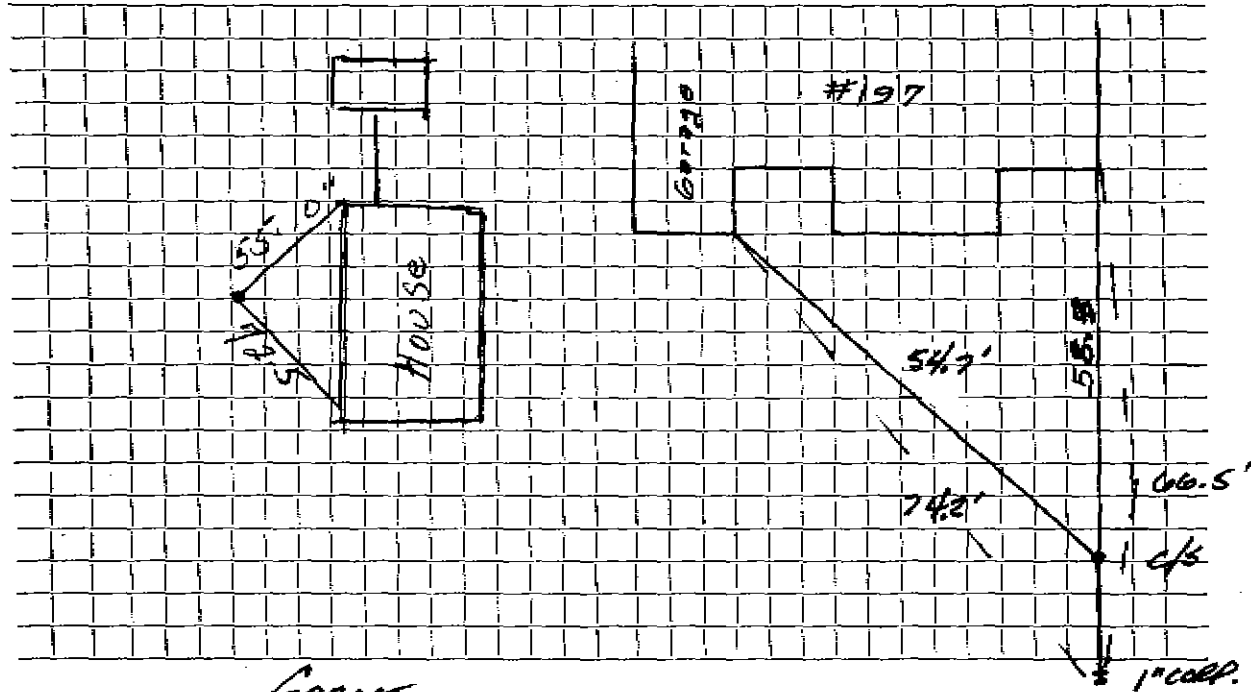

Connection made in GRANT Street. Work completed Contract #12

Remarks:

.....

.....