

WATER SERVICE RECORD

Name W. Lojek

# 3411

Service No. 54

Address 203 Grant Street

Location

~~Water Service~~ New Service


Comm 6-1-59

Date	Material	Amount	Total	Date	Amount
4-21-59	Labor	27.38		4-16-59	Deposit 100.00
	10 % O.H.	2.74	30.12	4-1-59	Retard 21.73
	52' 3/4" Copper tubing @.3666		19.06		78.27
	1 3/4" C x 1/2 I.W.H. Stop & Waste	5.84			NON CHARGE
	1 1/2 hr. Town Shovel @ 6.50	9.75			Labor 5.78
	2 hrs. Trucking @ .75	1.50			11' 3/4" Copper tubing @.3666 4.03
	12 x 3 Patch		12.00		1 3/4" C Corp Cock 4.64
			78.27		1 3/4" C Curb Cock 6.03
					1 Box & Rod 5.00
					1 1/2 Straight tailpiece .50
					1 1/2 Offset tailpiece .50
					1/2 hr. Town Shovel @6.50 3.25
					29.73
				2.97	20 # 1" copper
					1 1" corp.
					1 1" x 3/4" unions
					1 1" c/s w/box

DATE 7.97

TOWN OF LEXINGTON — BOARD OF PUBLIC WORKS  
WATER DIVISION

Sketch of Service Here

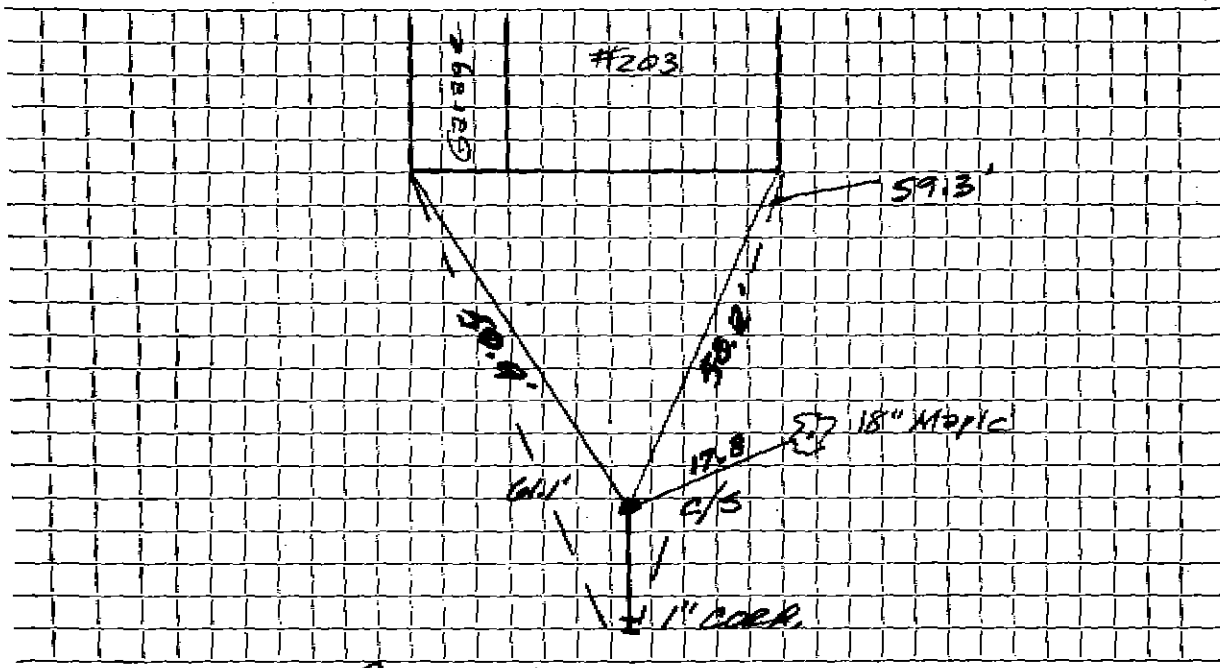

Connection made in GRANT Street. Work completed CONTRACT 96-2

Remarks: .....

.....

.....