


DATE January 2018

TOWN OF LEXINGTON — BOARD OF PUBLIC WORKS

WATER DIVISION

Sketch of Service Here

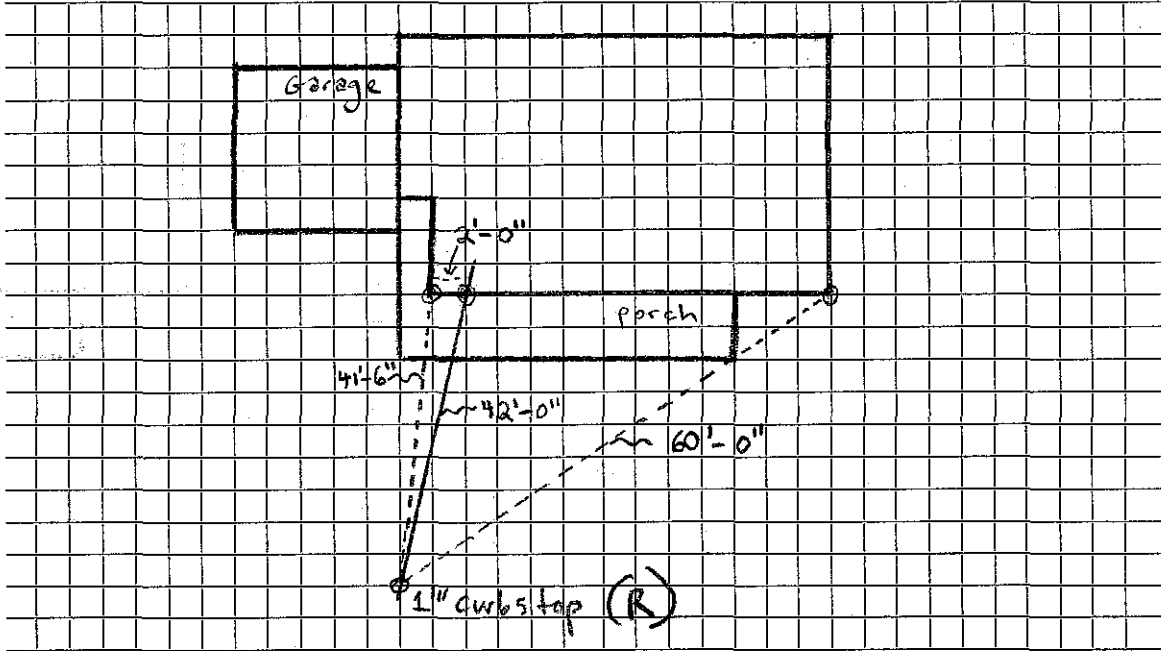

Connection made in 49 Grant Street Street. Work completed

Remarks:

.....

.....