


DATE NOV. 13 1997

TOWN OF LEXINGTON — BOARD OF PUBLIC WORKS

WATER DIVISION

Sketch of Service Here

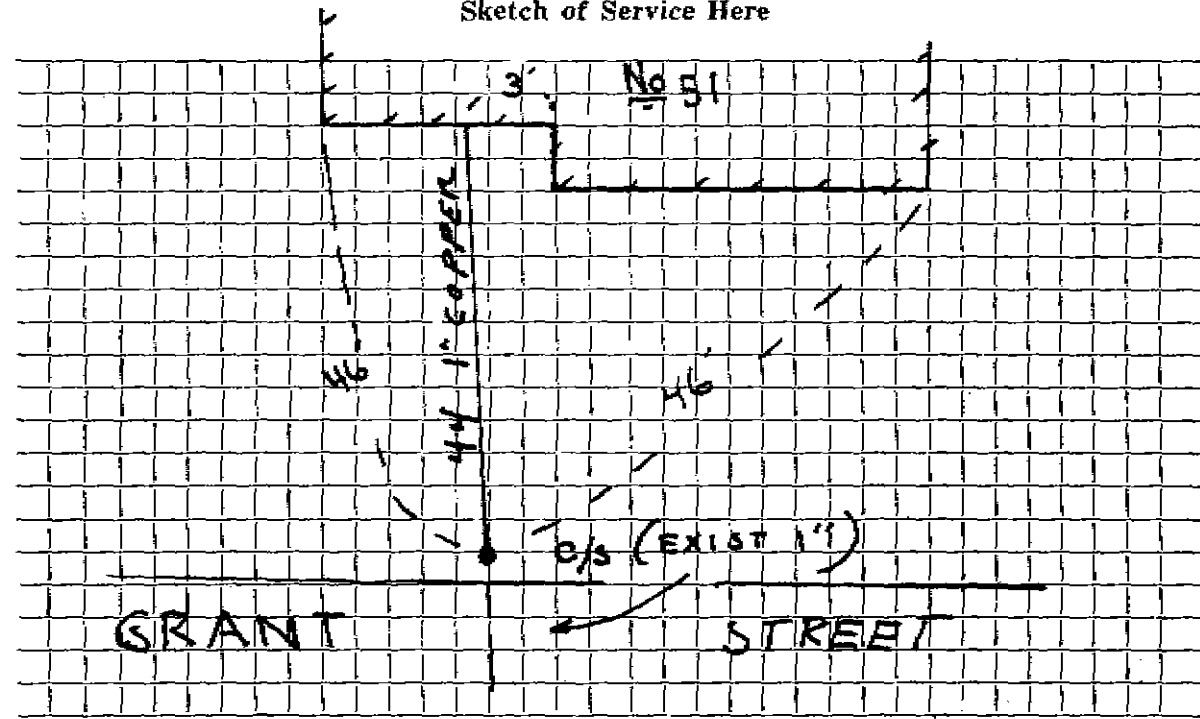

Connection made in GRANT Street. Work completed REDMOND

Remarks:

FIELD BOOK 97-4

TJM


DATE _____

TOWN OF LEXINGTON — BOARD OF PUBLIC WORKS

WATER DIVISION

Sketch of Service Here

51 GRANT ST.

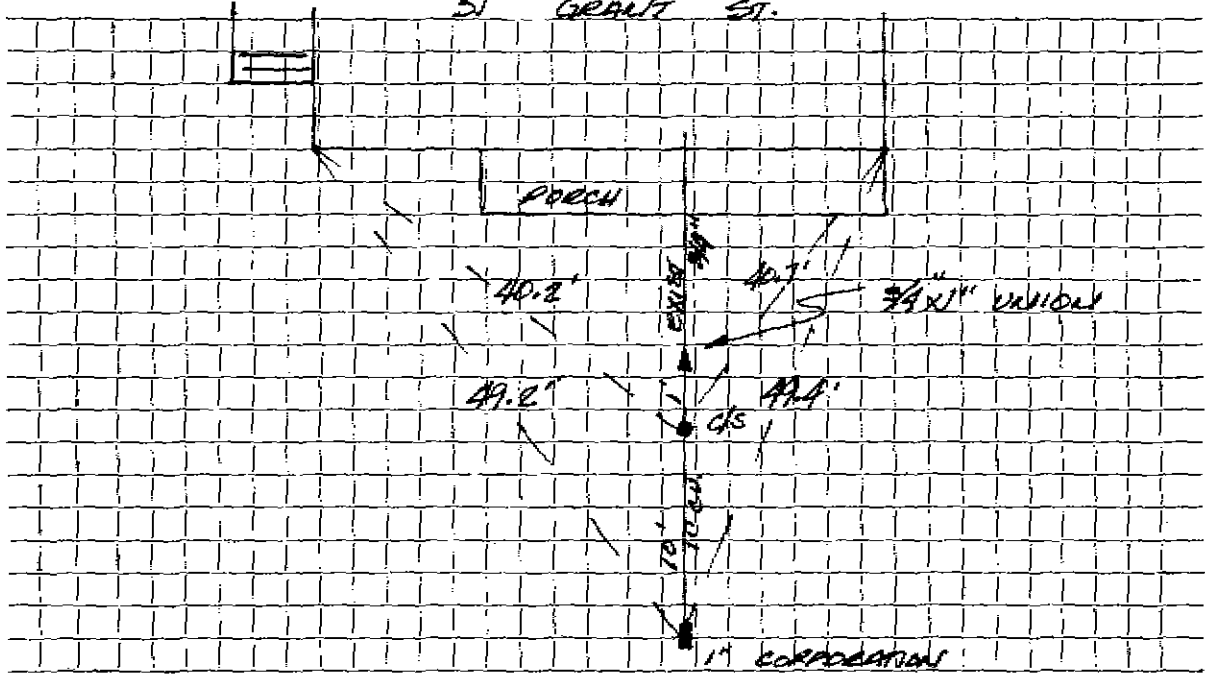

Connection made in Street. Work completed

Remarks: ORIGINAL SERVICE 12.9.58