




DATE \_\_\_\_\_

TOWN OF LEXINGTON — BOARD OF PUBLIC WORKS

**WATER DIVISION**

Sketch of Service Here

54 GRANT ST.

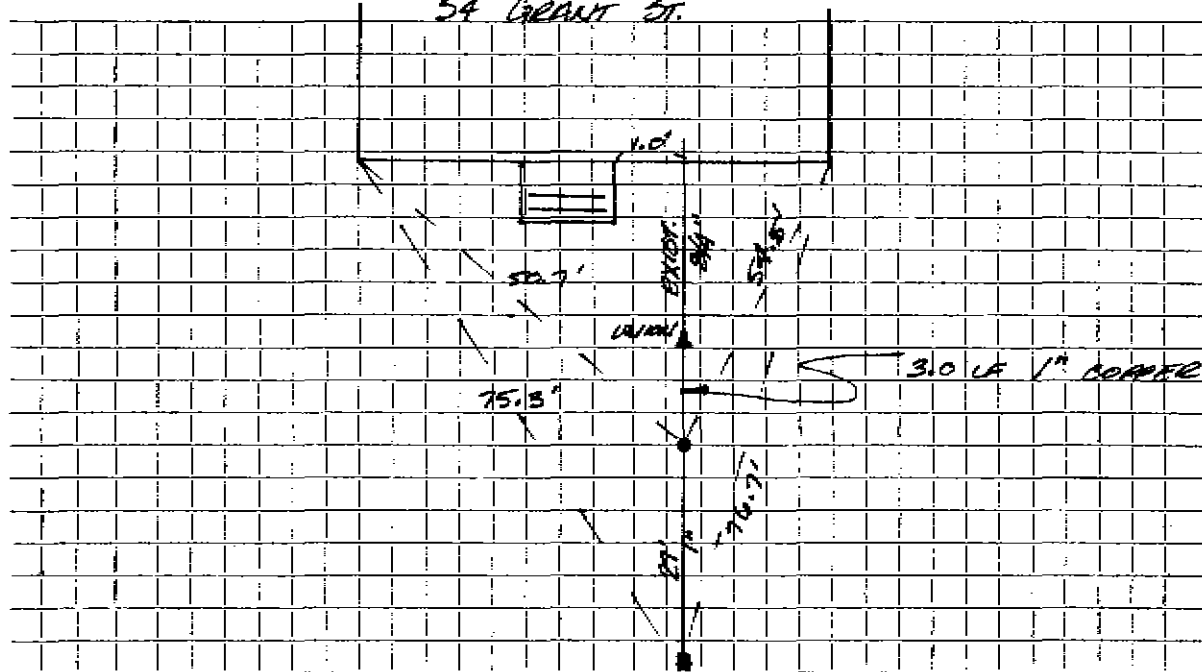

Connection made in ..... Street. Work completed .....

Remarks: .. ORIGINAL .. SERVICE .. 8.7.68 .....