


TOWN OF LEXINGTON - BOARD OF PUBLIC WORKS
 WATER DIVISION

Date: 9/2021

SKETCH OF SERVICE HERE

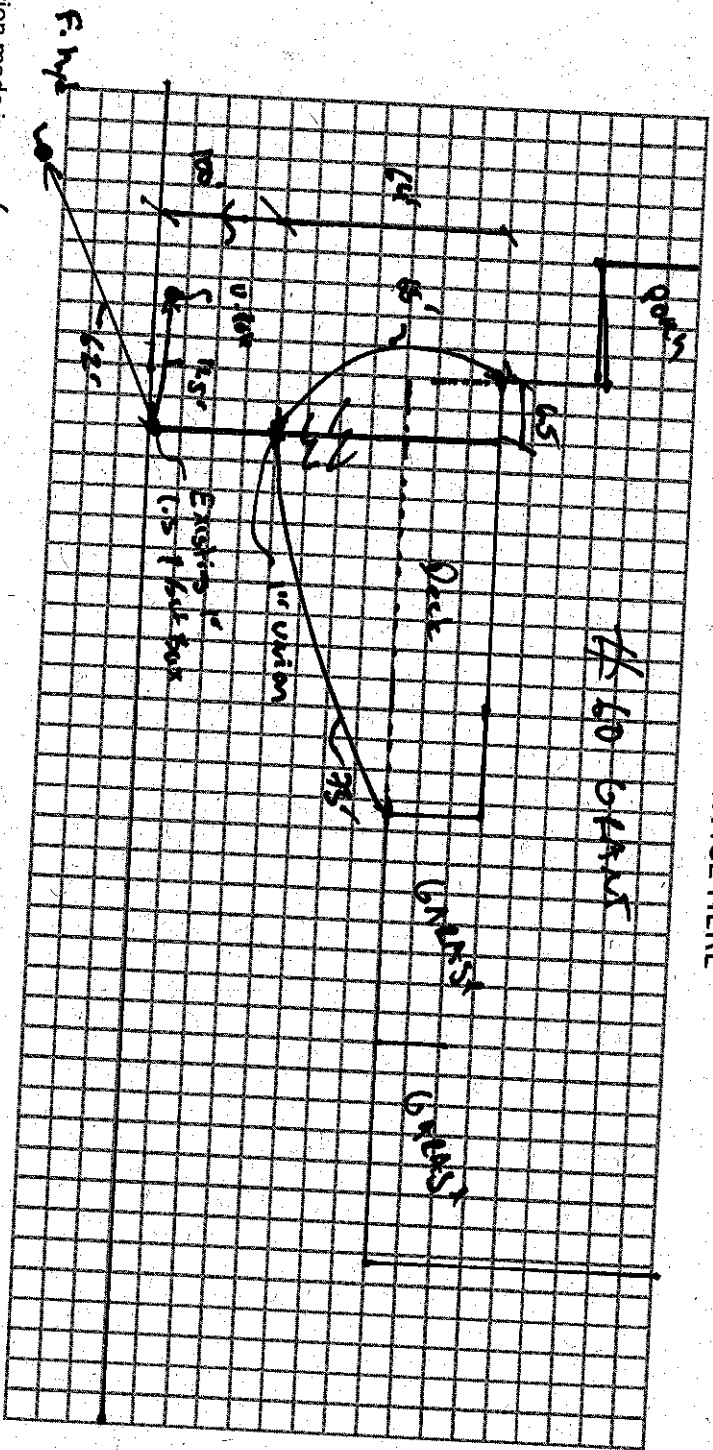

Connection made in: GEANT ST

Remarks: _____ Street: _____

Work completed: _____

Address 56/60 GRANT ST

Location

Repair - Renewal - New Service


Date	Material	Amount	Total	Date		A
9/2021	Buf. box (Existing)	①				
	1/2" (1.5) CANS BRASS					
	Type K 1" Copper	100'				
	1" UNION BRASS	①				
	Type K 1" Copper	64'				

DATE _____

TOWN OF LEXINGTON — BOARD OF PUBLIC WORKS

WATER DIVISION

Sketch of Service Here

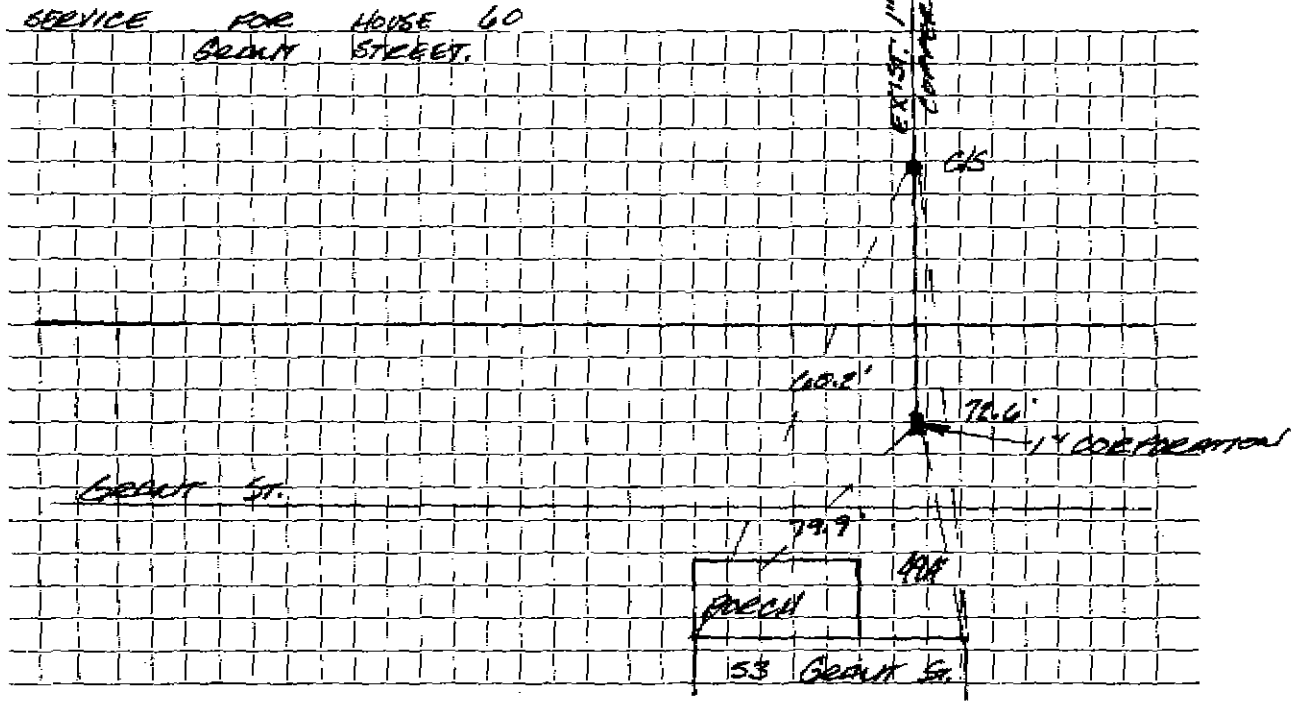

Connection made in Street. Work completed

Remarks:

.....

.....