


DATE _____

TOWN OF LEXINGTON — BOARD OF PUBLIC WORKS

WATER DIVISION

Sketch of Service Here

LOT GRANT ST.

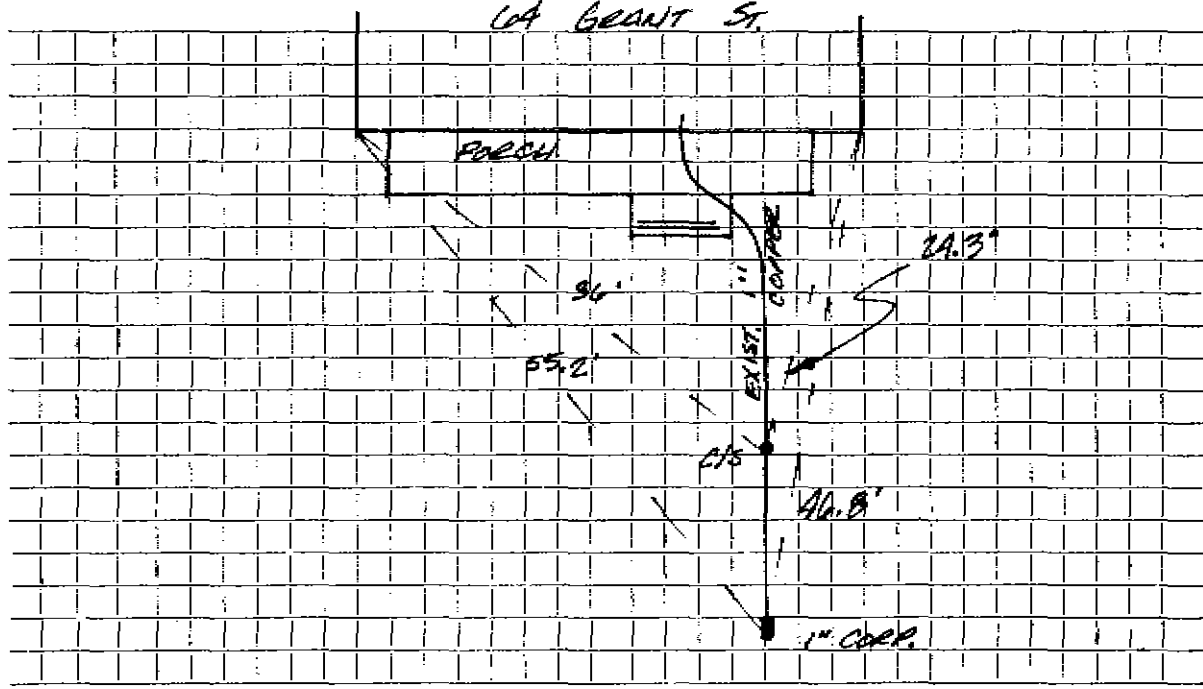

Connection made in Street. Work completed

Remarks: SERVICE WAS RENEVED IN 1988.