

WATER SERVICE RECORD

Name

Service No.

Address 77 GRANT STREET

Location


Repair—Renewal—New Service

Date	Material	Amount	Total	Date	OUTSIDE	Amount
	LABOR	5 <sup>00</sup>		9-17-97		
5-4-04	10% O.H.	.51	5 <sup>59</sup>		17 LF 1" COPPER	
	92 LF 3/4" COPPER	@ .42	13 <sup>44</sup>		1- 1" CORPORATION	
	1 3/4" C X 1/2" I.W.H	STOP & WASTE	6 <sup>17</sup>		1- 1" C/S	
	1 HRS <del>FOR</del> TRUCKING	@ \$3.00	3 <sup>00</sup>		1- 3/4" X 1" VALVE	
			<u>\$28<sup>20</sup></u>			

DATE 9-17-96

TOWN OF LEXINGTON — BOARD OF PUBLIC WORKS  
WATER DIVISION

Sketch of Service Here

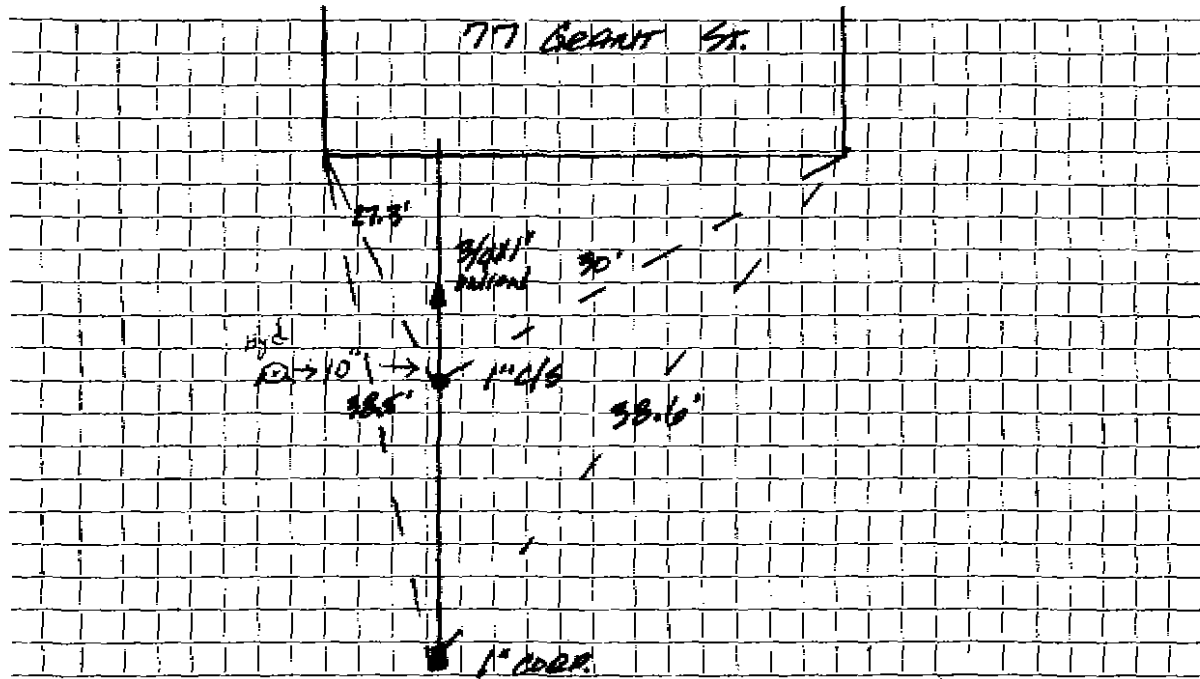

Connection made in ..... Street. Work completed .....

Remarks: ORIGINAL SERVICE 5-4-64

Curb 10" from right side of hyd. - 6" from front of side w + bt. 1 N. E x 5.5