

WATER SERVICE RECORD

Name LUIGINO COSCIA

Service No.

Address 79 GRANT ST.

Location

Repair—Renewal—New Service

KID # B663


Date	Material	Amount	Total	Date	NO CHARGE	Amount
5.5.64	LABOR	20 99		9.24.94	11 LF 1" COPPER	
	10% OH	2 10	23 09		1 1" COOPERATION	
	32 LF 3/4" COPPER		13 44		1 1" CURB STOP	
	1 3/4" x 1/2" STOP & WASTE		6 17		1 1" x 3/4" FENCE	
	1 YARD LOOM & FEED	3 00	3 00			
	2 HRS. TOWN SHOVEL	6 50	13 00			
	1 HR. TRENCHING	3 00	3 00			
			\$ 61 70			
	PAID 9.21.64					

DATE 9.24.96

TOWN OF LEXINGTON — BOARD OF PUBLIC WORKS  
WATER DIVISION

Sketch of Service Here

79 GRANT ST.

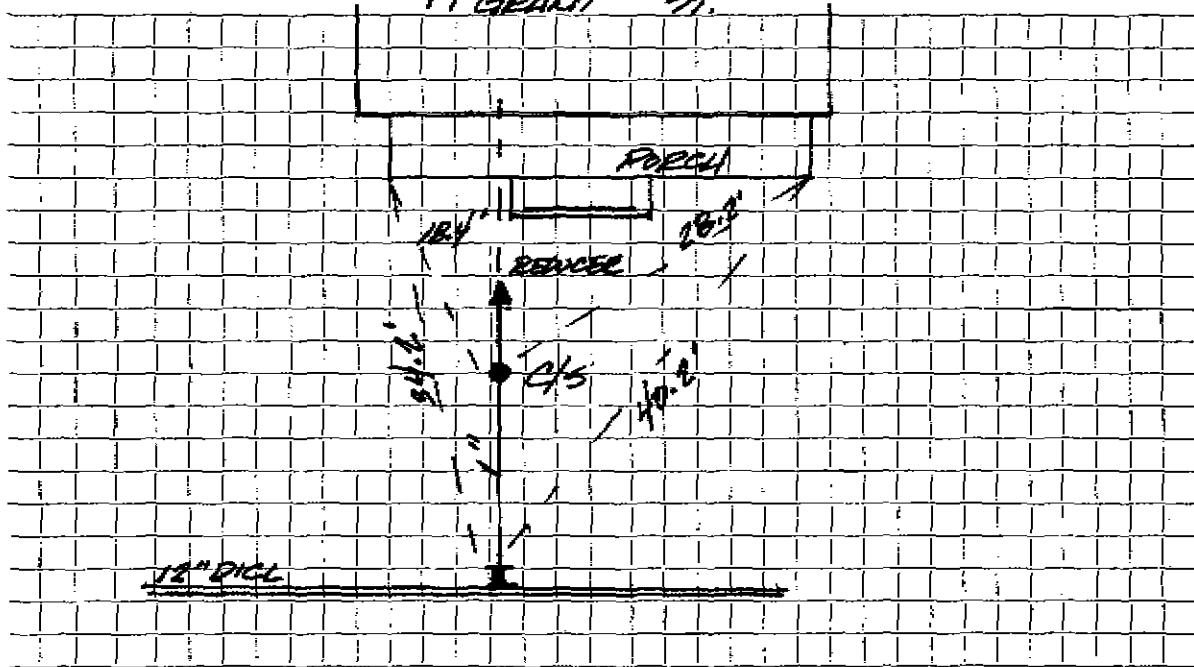

Connection made in GRANT Street. Work completed CONTRACT 96-2

Remarks: .....

.....

.....