


DATE _____

TOWN OF LEXINGTON — BOARD OF PUBLIC WORKS
WATER DIVISION

Sketch of Service Here

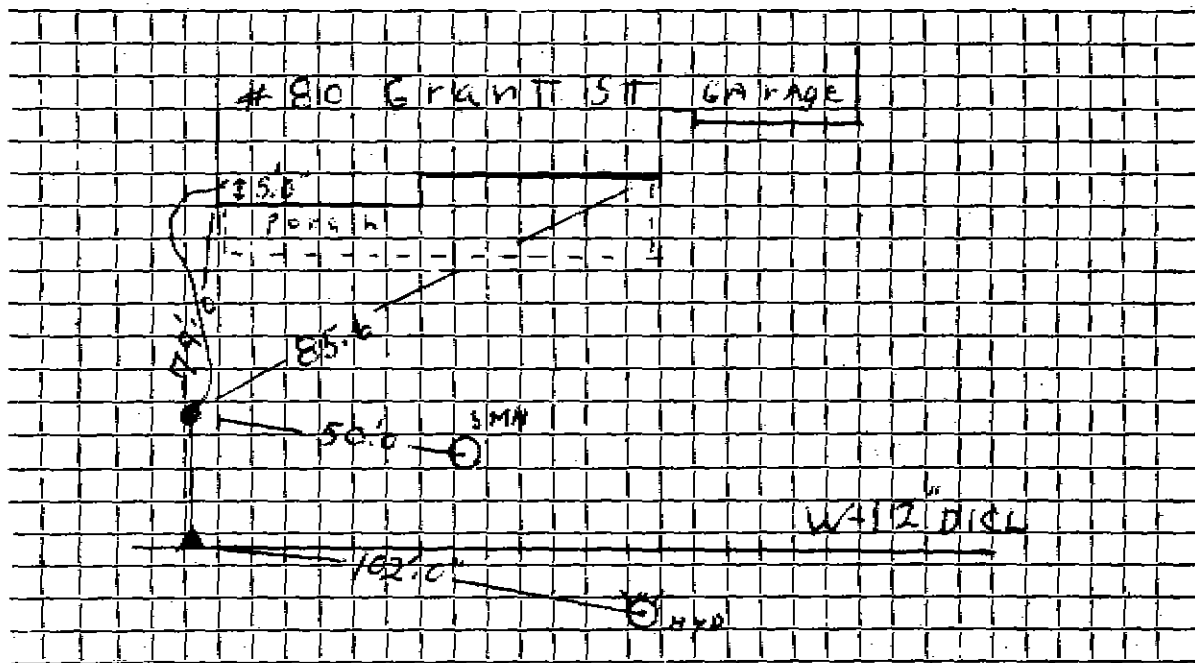

Connection made in Grant St. Street. Work completed 9/05 / 12/06 McLaughlin

Remarks: