

WATER SERVICE RECORD

Name HARRIS GOODWIN

Service No. \_\_\_\_\_

Address 82 GRANT STREET

Location \_\_\_\_\_


Repair—Renewal—New Service

Date	Material	Amount	Total	Date	Amount
7.23.49	LABOR	1 25	1 25	10.8.96	33 LF 1" COPPER
	10% OH		13		1 1" CORPORATION
	42 LF 3/4" COPPER	.24	10 08		1 1" CURB STOP
	1 3/4" x 1/2" S/W		3 27		1 1" x 3/4" REDUCER
	1 HR TRICKING		75		
			<u>15 50</u>		
	PAID 7.11.49	\$20			
	REFUNDED 12.21.49	(\$4.50)			

DATE 10.8.96

TOWN OF LEXINGTON — BOARD OF PUBLIC WORKS  
WATER DIVISION

Sketch of Service Here

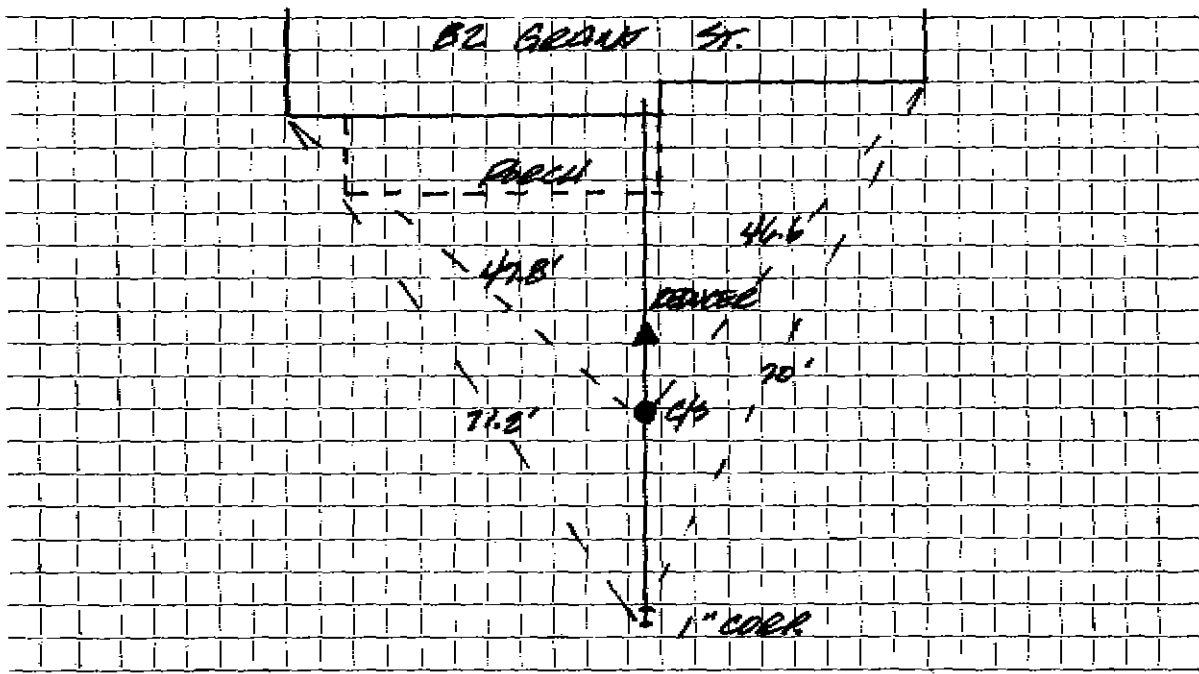

Connection made in GRANT Street. Work completed CONTRACT 96-2

Remarks: .....