

WATER SERVICE RECORD

Name LOUIS PORTAIS

Service No.

Address 83 GRANT STREET

Location

Repair—Renewal—New Service

Date	Material	Amount	Total	Date	Amount
9.9.47	LABOR	1 10	1 10	10.8.96	17 LF 1" COPPER
	10% OH		11		1- 1" COPPERATION
	31 LF 3/4" COPPER	.26	8 06		1- 1" CUB STOP
	1 3/4" SWK	3 15	3 15		1- 1" X 3/4" REDUCER
	1 HR TRUCKING	.75	.75		
			13 17		

PAID 8.29.47


DATE 10.2.96

TOWN OF LEXINGTON — BOARD OF PUBLIC WORKS

WATER DIVISION

Sketch of Service Here

*83 GRANT*

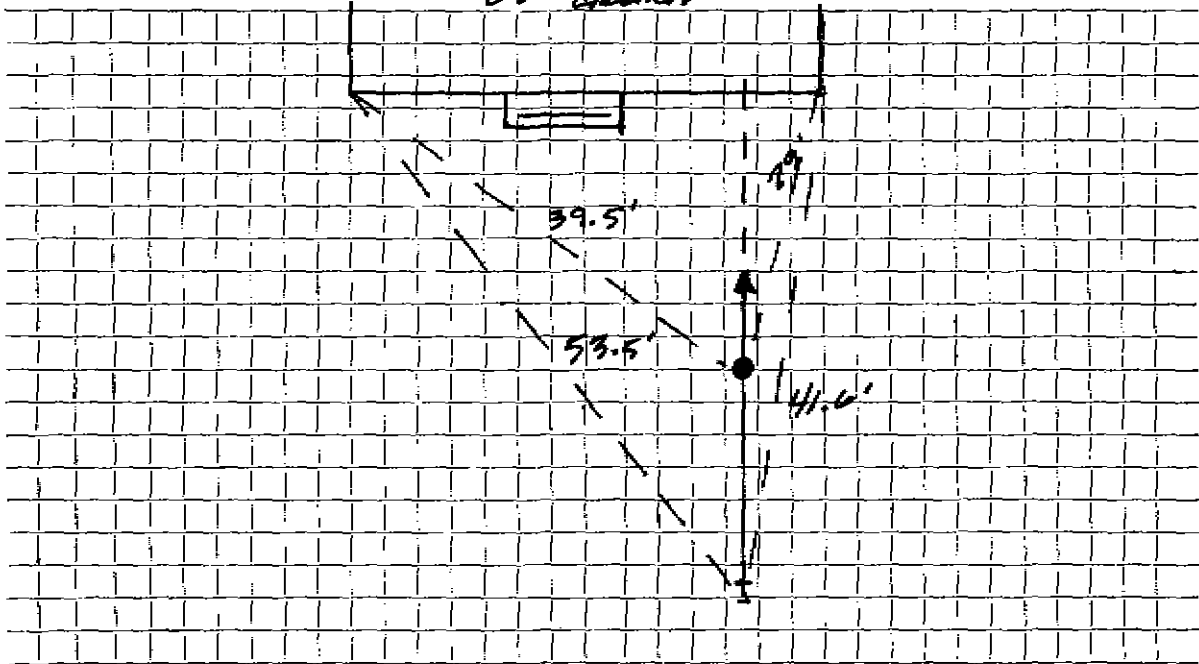

Connection made in ... GRANT ... Street. Work completed CONTRACT 96-2 .....

Remarks: .....  
.....  
.....