

WATER SERVICE RECORD

Name PAUL W. SHERMAN

Service No.

Address 85 GRANT ST.

Location


Repair—Renewal—New Service

Date	Material	Amount	Total	Date	Material	Amount
12.20.77	LABOR	71.85		10.9.96		
	10% OIL	7.18	79.03	27	LF 1" COPPER	
4	LF 3/4" COPPER	.85	3.32	1	3/4x1" UNION	
1	3/4-3PT. UNION		5.63	1	1" CORPORATION	
1	HR TRUCKING		3.00	1	CURE & STOP	
1 1/2	BACKHOE	6.50	9.75			
			100.78			
	PAID 12.29.77					
4.4.48	37 LF 3/4" COPPER					
	1 3/4" ST W					

DATE 10.9.96

TOWN OF LEXINGTON — BOARD OF PUBLIC WORKS  
WATER DIVISION

Sketch of Service Here

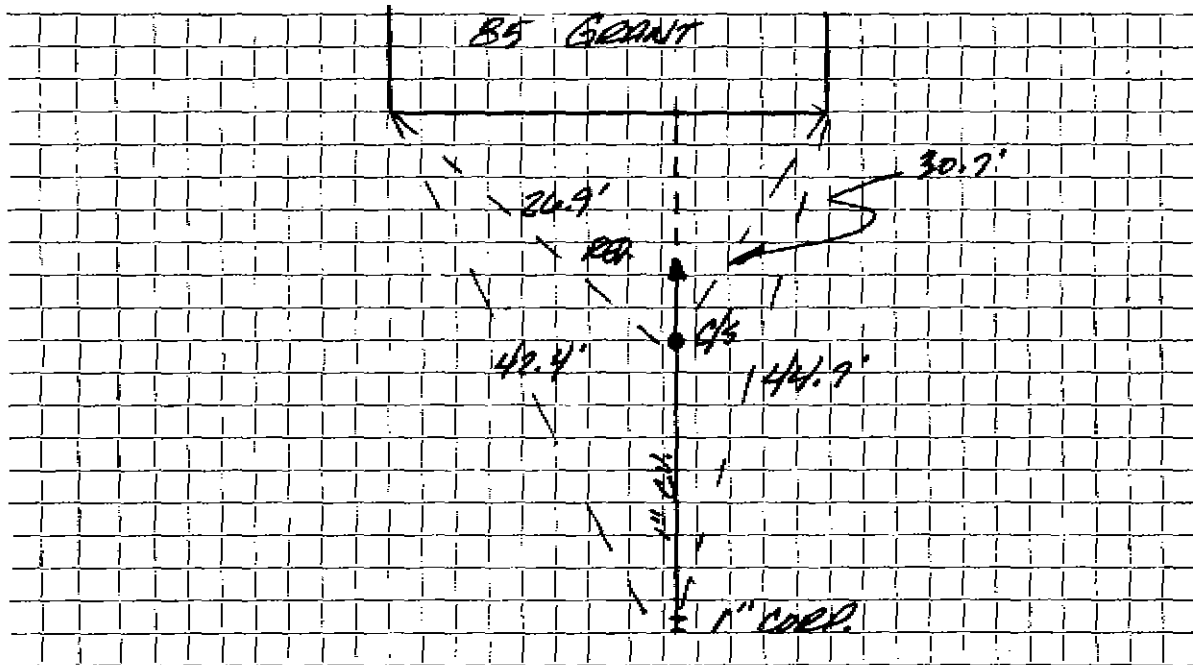

Connection made in GRANT Street. Work completed CONTRACT 96-2

Remarks: .....

.....

.....