


DATE C/2017

TOWN OF LEXINGTON — BOARD OF PUBLIC WORKS
WATER DIVISION

Sketch of Service Here

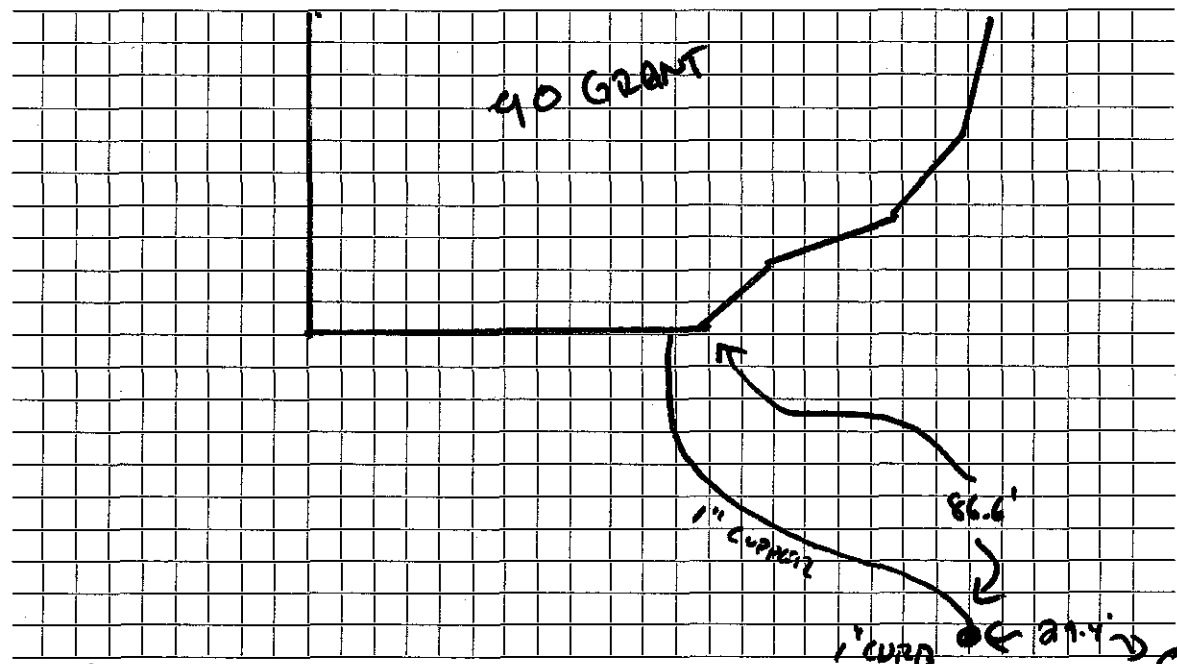

Connection made in GRANT Street. Work completed HANICINS SMIT ON GRANT

Remarks:

.....

.....