

WATER SERVICE RECORD

Name LOUIS PORTAIS

Service No.

Address 91 GRANT STREET

Location

Repair—Renewal—New Service


Date	Material	Amount	Total	Date	Amount
11-26-48	LABOR	1 15	1 15	10-12-96	
	10% oil		12	24	LF 1" COPPER
	52 LF 3/4" COPPER	25	13 26	1	1" COOP.
	1 3/4" x 1/2" S 1/2		3 15	1	1" C/S
	1 HE TRUCKING	75	75	1	1" x 3/4" UNIONS
			18 43		

DATE 10.12.96

TOWN OF LEXINGTON — BOARD OF PUBLIC WORKS
WATER DIVISION

Sketch of Service Here

9' GRANT

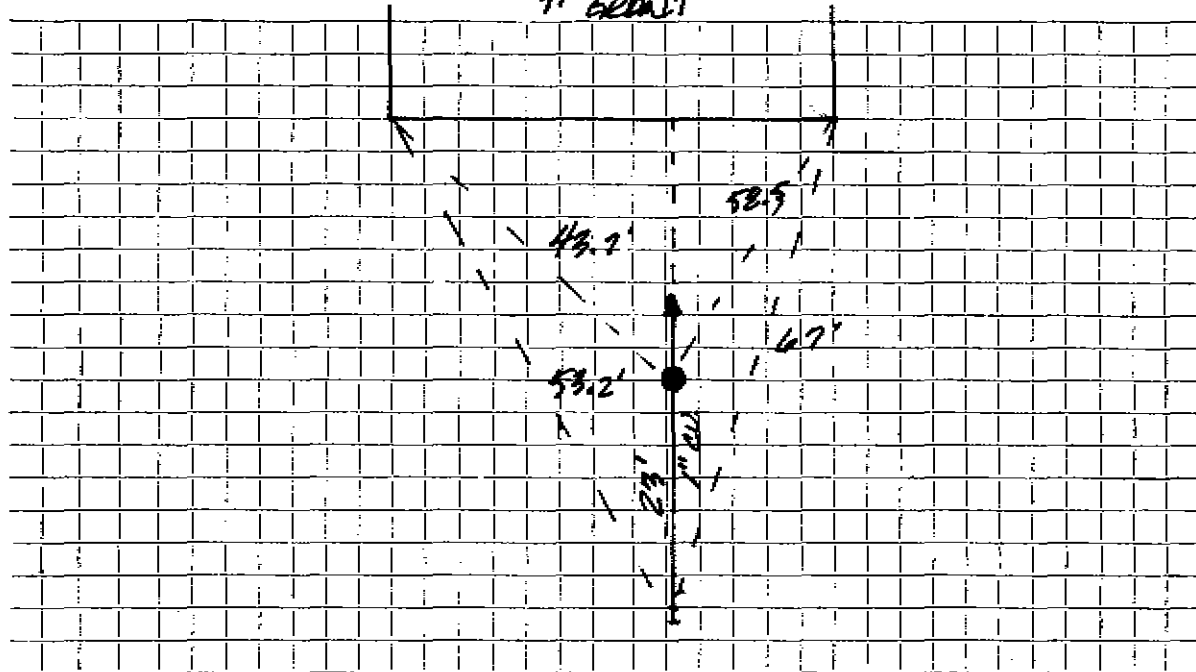

Connection made in GRANT Street. Work completed CONTRACT 96-2

Remarks:

.....

.....