

WATER SERVICE RECORD

Name E. Crouch

Service No. 32

Address 11 Grapevine Avenue

Location Lexington, Mass.

~~Repair~~—Renewal—~~New Service~~

Com. 5-21-51


Date	Material	Amount	Total	Date	Material	Amount
3-9-51	Labor	1 35	1 35	May 8 '51	Insulated	20 00
	10% Overhead		14	June 25 '51	Lead	3 96
	50' - 3/4" Copper Tubing @.36	18 00			No Charge	25 96
	1 - 3/4" C x 1/2" I.W.H. S&W	4 00		3-9-51	Labor	1 35
	1 - 3/4" C x 3/4" C Union (3pts)	1 72			14' - 3/4" Copper Tubing @.36	5 04
	Trucking 1 hr. @.75		75		1 - 3/4" C Corp-cock	4 33
			25 96		1 - 3/4" C x 3/4" C Curb-cock	4 67
					1 - Box & Rod	4 68
					1 - 1/2" Offset Tail Piece	50
					1 - 1/2" Straight Tail Piece	50
					Trucking 1 hr. @.75	75
						21 82

DATE \_\_\_\_\_

TOWN OF LEXINGTON — BOARD OF PUBLIC WORKS  
WATER DIVISION

Sketch of Service Here

NEW — MAY — 1957

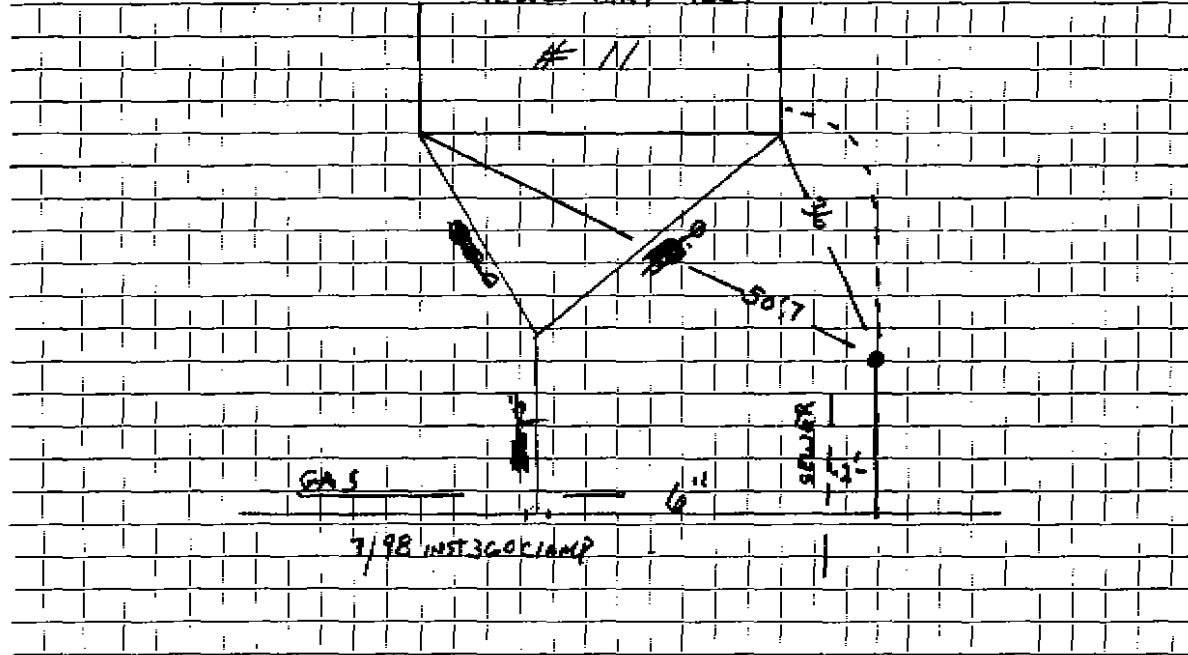

Connection made in ..... Street. Work completed .....

Remarks: .....

.....