

Name A. Clifford Fletcher

Service No. 93

Address 12 Grapevine Avenue

Lexington, Mass.

Location 12 Grapevine Avenue

Kind of Pipe

Size

Size of Main

~~Repair to Existing~~ New Service

Com. 7-3-50

Location

Date

Material

Amount

Total

Date

Amount

June 5, '50

Labor

1 30

1 30

10% Overhead

13

36' - 3/4" Copper Tubing @.23

8 28

1 - 3/4" C x 1/2" I.W.H. S&W

3 29

Trucking 1 hr. @.75

75

13 75

*May 15 '50*

*July 20 '50*

*Repaired*

*No Charge*

20 00

13 75

June 5, '50

Labor

1 30

38' - 3/4" Copper Tubing @.23

8 74

1 - 3/4" C Corp-cock

3 15

1 - 3/4" C x 3/4" Curb-cock

3 85

1 - 3/4" C x 3/4" C Union (3pts)

1 39

1 - Box & Rod

3 35

1 - 1/2" Offset Tail Piece

38

1 - 1/2" Straight Tail Piece

38

Trucking 1 hr. @.75

75

Labor

23 29

TOWN OF LEXINGTON - BOARD OF PUBLIC WORKS

**WATER DIVISION**

The undersigned applies for a supply of water at No..... St. and hereby agrees to comply with the rules and regulations as now, or at any future time, established by the Board of Selectmen.

Am't of Estimate \$.....

Owner .....


Am't Paid \$.....

Address .....

Builder .....

.....

Sketch of Service Here

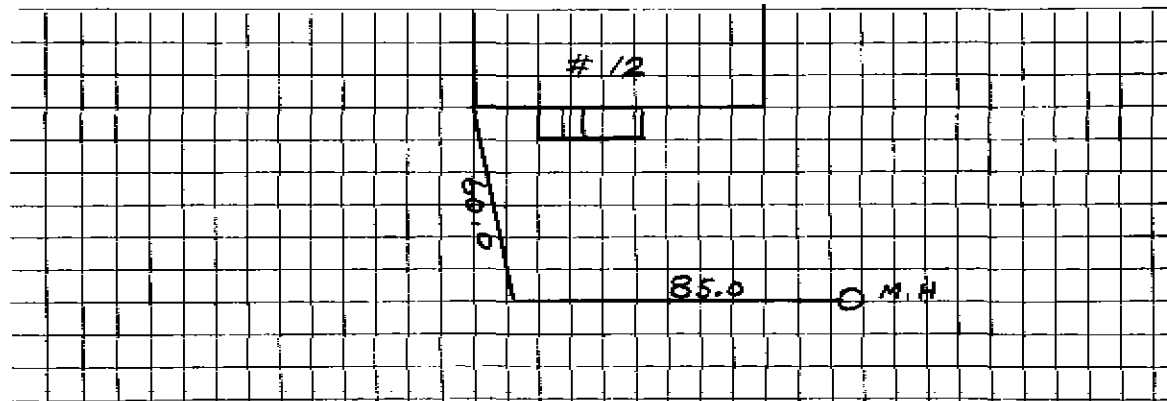

Connection made in ..... Street.

Work completed .....19

Remarks: