

WATER SERVICE RECORD

Name

Service No.

Address 14 Grapevine Avenue

Location

~~XXXXXXXXXX~~ ~~Repair~~ ~~Renewal~~ ~~New Service~~ ~~XXXXXXXXXX~~ W.O. #1460 Jack Quinlan


Date	Material	Amount	Total	Date	Amount
9-4-85	57' 1" Copper tubing				
	1 1" Union				
	1 1" Valve				
					OUTSIDE
				11/10/80	Labor
					34' 1" Copper tubing
					1 1" Curb
					1 1" Corp-
					1 1" x 1/2 Reducer
					1 1" x 5" C.L. Nipple
					1 1" Style 38
					Patch 23' x 14'
					3 hrs. Trucking
					4 hrs. Town Shovel

DATE _____

TOWN OF LEXINGTON — BOARD OF PUBLIC WORKS

WATER DIVISION

Sketch of Service Here

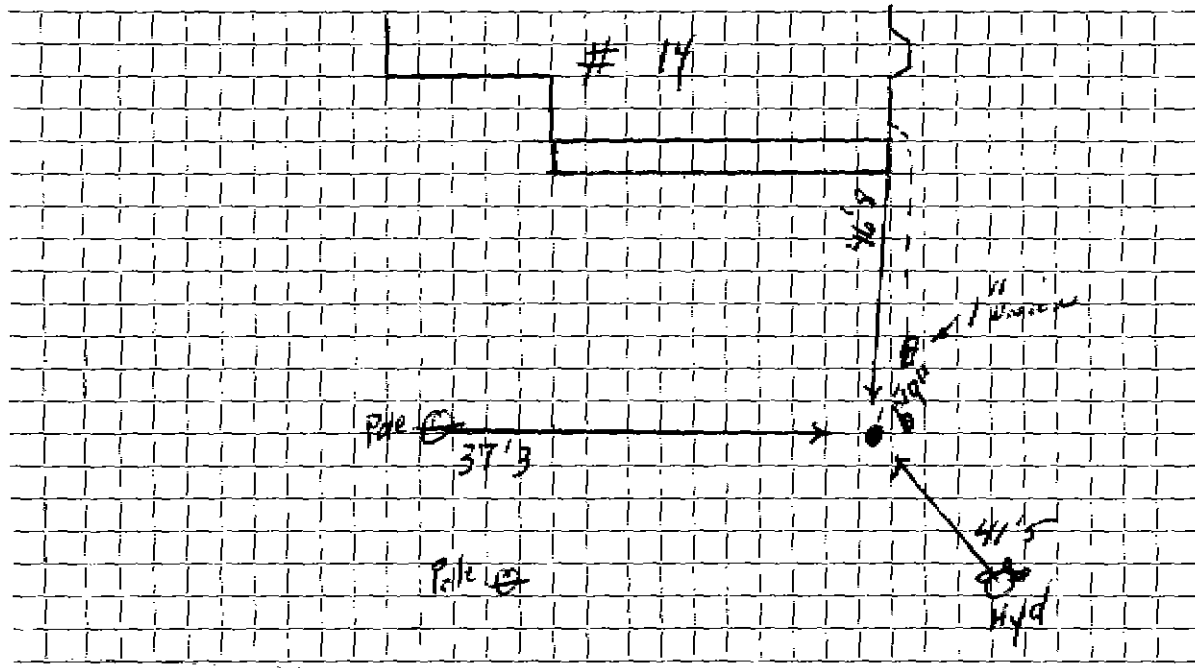

Connection made in Street. Work completed

Remarks:
.....
.....