

WATER SERVICE RECORD

Name Corinne Petrino

Service No. 6

Address 18 Grapevine Ave.

Location Lot 24

Repair—Renewal—New Service DeFlice #985


MAY 13 1968

Date		Material	Amount	Total	Date		Amount
4-16-68	44'	3/4" Copper tubing			4-3-68	Deposit	27 57
						NON CHARGE	
					1957		
					33' - 3/4"	Copper tubing	12 37
					1 3/4"	Corp. Cock	4 64
					1 3/4"	C Curb Cock	5 94
					1	Box & Rod	4 62
							27 57
						Service installed by contractor	

DATE _____

TOWN OF LEXINGTON — BOARD OF PUBLIC WORKS
WATER DIVISION

Sketch of Service Here

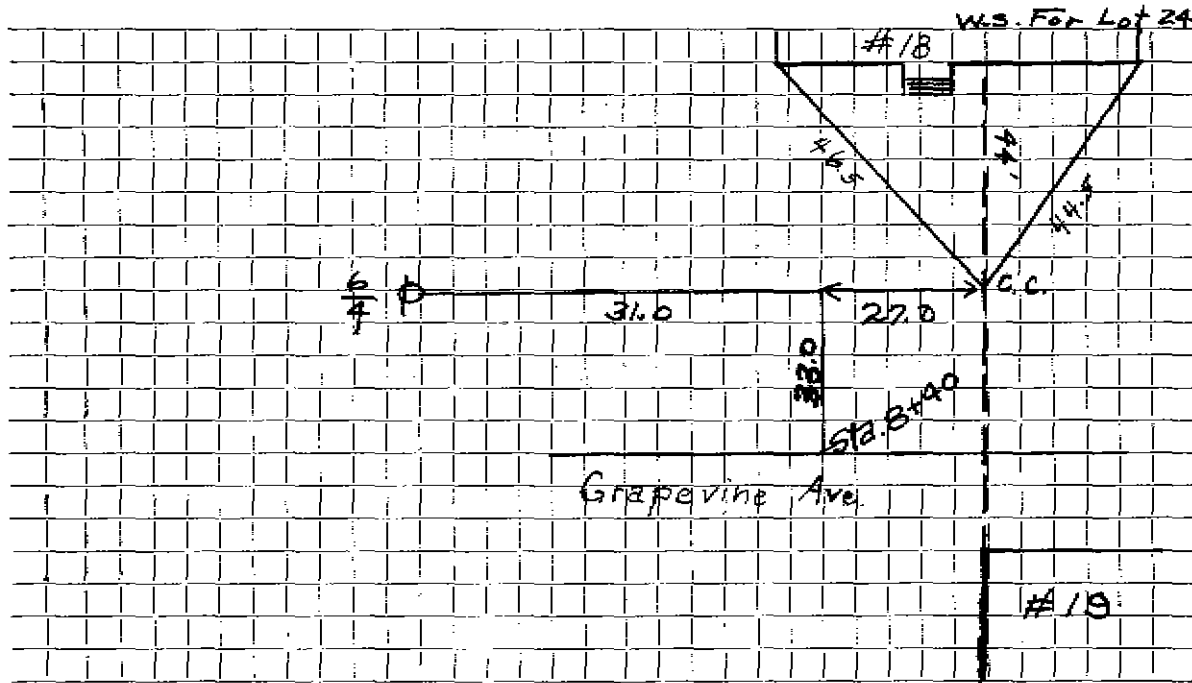

Connection made in Street. Work completed

Remarks:

.....

.....