

WATER SERVICE RECORD

Name Paul Huoppi

Service No. 183

Address 19 Grape Vine Avenue

#3092

Location Lexington, Mass.

~~XXXXXXXXXXXX~~ New Service


Com. 12-31-50

Date	Material	Amount	Total	Date	Material	Amount
Aug. 3, '50	Labor	1 30	1 30	July 24 '50	Repaired	25 00
	10% Overhead		13			
	45' - 3/4" Copper Tubing @.23		10 35		No Charge	15 82
	1 - 3/4" C x 1/2" I.W.H. S&W		3 29	Aug. 3, '50	Labor	1 30
	Trucking 1 hr. @.75		75		7' - 3/4" Copper Tubing @.23	1 61
			15 82		1 - 3/4" C Corp-cock	3 15
					1 - 3/4" C x 3/4" C Curb-cock	3 85
					1 - Box & Rod	3 35
					1 - 1/2" Straight Tail Piece	42
					1 - 1/2" Offset Tail Piece	42
					Trucking 1 hr. @.75	75
						14 85

DATE _____

TOWN OF LEXINGTON — BOARD OF PUBLIC WORKS
WATER DIVISION

Sketch of Service Here

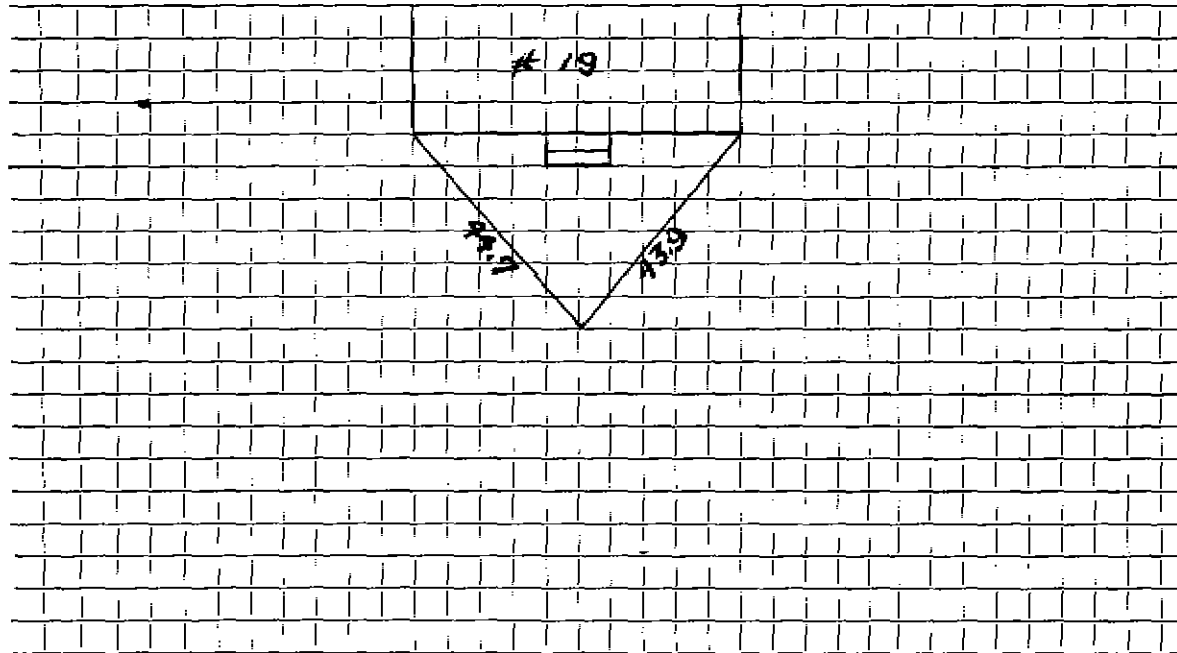

Connection made in Street. Work completed

Remarks:
.....
.....