

WATER SERVICE RECORD

Service No. 169

Name Esco Builders Corp.

Address 20 Grapevine Ave.

Location Lot 25

#5193

#6895

~~Repair Record~~ - New Service

CC# 7749

Comm 1-14-63


Date	Material	Amount	Total	Date	Amount
12-3-62	Labor	4.44		11-28-62	Deposit 35.00
	10% O.H.	.44	4.88	1-14-63	Refund 4.21
	47' 3/4" Copper tubing @.42		19.74		NON CHARGE 30.29
	1 3/4" C x 1/2" I.W.H. Stop & Waste		6.17	1957	
			30.79	35' - 3/4"	Copper tubing 19.87
				1 3/4"	Corp. Cock 4.64
				1 3/4"	C Curb Cock 5.94
				1	Box & Rod 4.62
					35.07
				1 1/2"	Straight tailpiece .50
				1 1/2"	Offset tailpiece .50
					Service installed by contractor 36.07

DATE _____

TOWN OF LEXINGTON — BOARD OF PUBLIC WORKS

WATER DIVISION

Sketch of Service Here

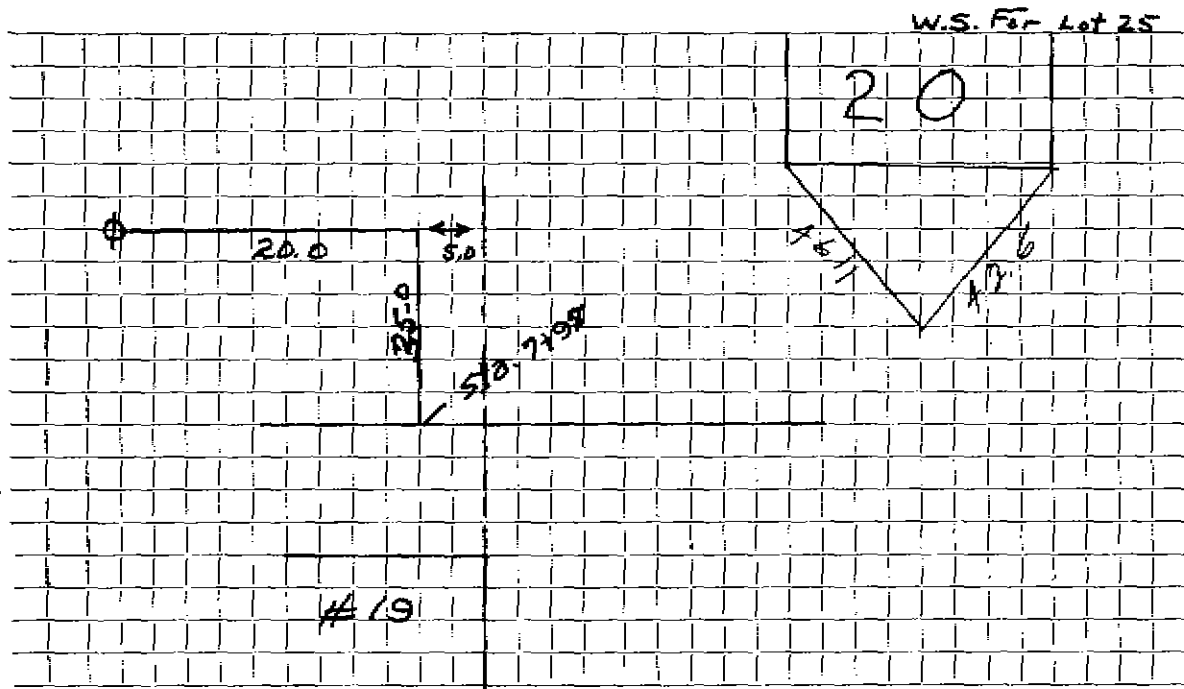

Connection made in Street. Work completed

Remarks:
.....
.....