

ESCO BUILDERS CORPORATION
 WATER SERVICE RECORD

1043 - #1714

Name Esco Builders Corporation

Service No. 6

Address 22 Grapevine Ave

Location Lot 26

Repair—Renewal—New Service

Comm 4-22-63


Date	Material	Amount	Total	Date	Amount
4/10/63	Labor	4 73		3-29-63	Deposit 35 00
	10% O.H.	47	5 20	4-22-63	Refund 2 63
	50' 3/4" Copper Tubing @ .42		21 00		NON CHARGE 32 32
	1 3/4" Cx 1/2 I.W.H. Stop & Waste		6 17		
			32 37	1957	
				33' - 3/4" Copper Tubing	12 37
				1 3/4" Corp Cock	4 64
				1 3/4" G Curb Cock	5 94
				1 Box & Rod	4 62
					27 57
				1 1/2 Straight Tailpiece	50
				1 1/2 Offset Tailpiece	50
					28 57
				Service installed by contractor	

DATE _____

TOWN OF LEXINGTON — BOARD OF PUBLIC WORKS

WATER DIVISION

Sketch of Service Here

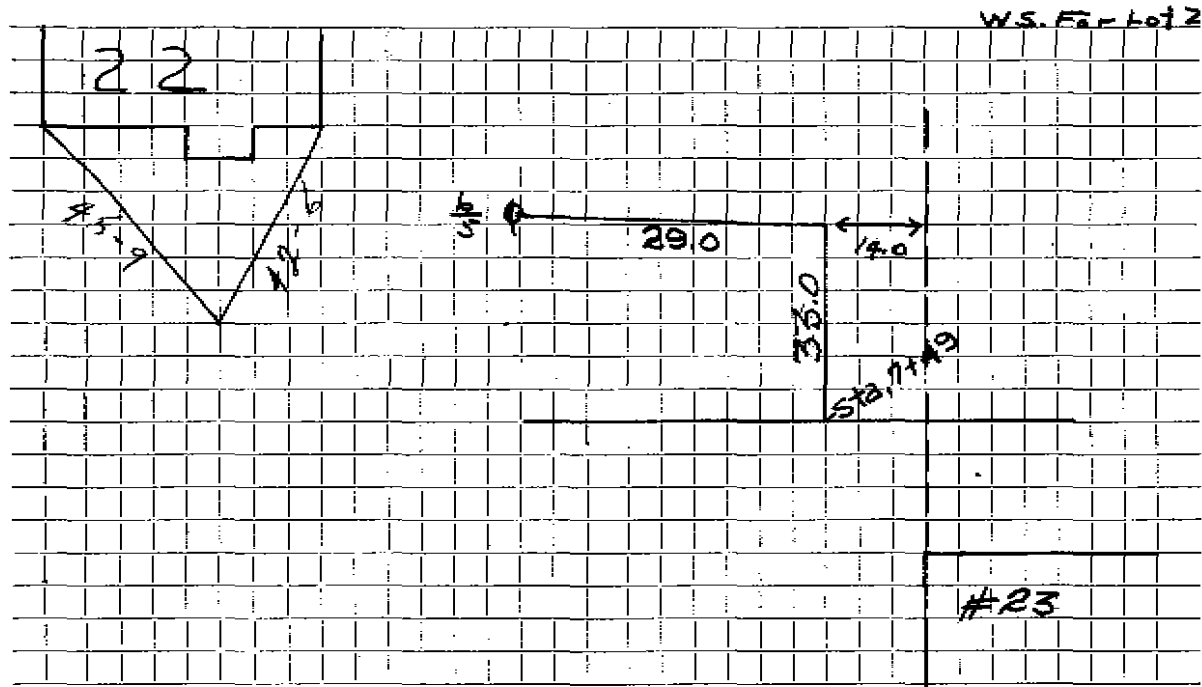

Connection made in Street. Work completed

Remarks:
.....
.....