

WATER SERVICE RECORD

277

Name Esco Builders Corp.

Service No. 32

Address 24 Grapevine Ave.

Location Lot 27

~~Repair/Deposit~~ - New Service WC 7912

Comm 6-3-63

| Date | Material | Amount | Total | Date | | Amount |
|---------|------------------------------------|--------|-------|---------------|--------------------------|--------|
| 5-16-63 | Labor | 4.53 | | 5-14-63 | Deposit | 75.00 |
| | 10% O.H. | .45 | 4.98 | 6-3-63 | Refund | 32.51 |
| | 48' 3/4" Copper tubing @.42 | | 20.16 | | NON CHARGE | 42.49 |
| | 1 3/4" G x 1/2 I.W.H. Stop & Waste | | 6.17 | 1967 | | |
| | 1 3/4" G Curb Cock | | 6.28 | 3 1/4" - 3/4" | Copper tubing | 16.12 |
| | 1 Box & Rod | | 4.90 | 1 3/4" | Corp Cock | 4.64 |
| | | | 42.49 | 1 3/4" | G Curb Cock | 5.94 |
| | | | | 1 | Box & Rod | 4.62 |
| | | | | | | 31.32 |
| | | | | | 1 1/2 Straight tailpiece | .50 |
| | | | | | 1 1/2 Offset tailpiece | .50 |
| | | | | | | 32.32 |

Service installed by contractor


DATE _____

TOWN OF LEXINGTON — BOARD OF PUBLIC WORKS

WATER DIVISION

Sketch of Service Here

W.S. For lot 27

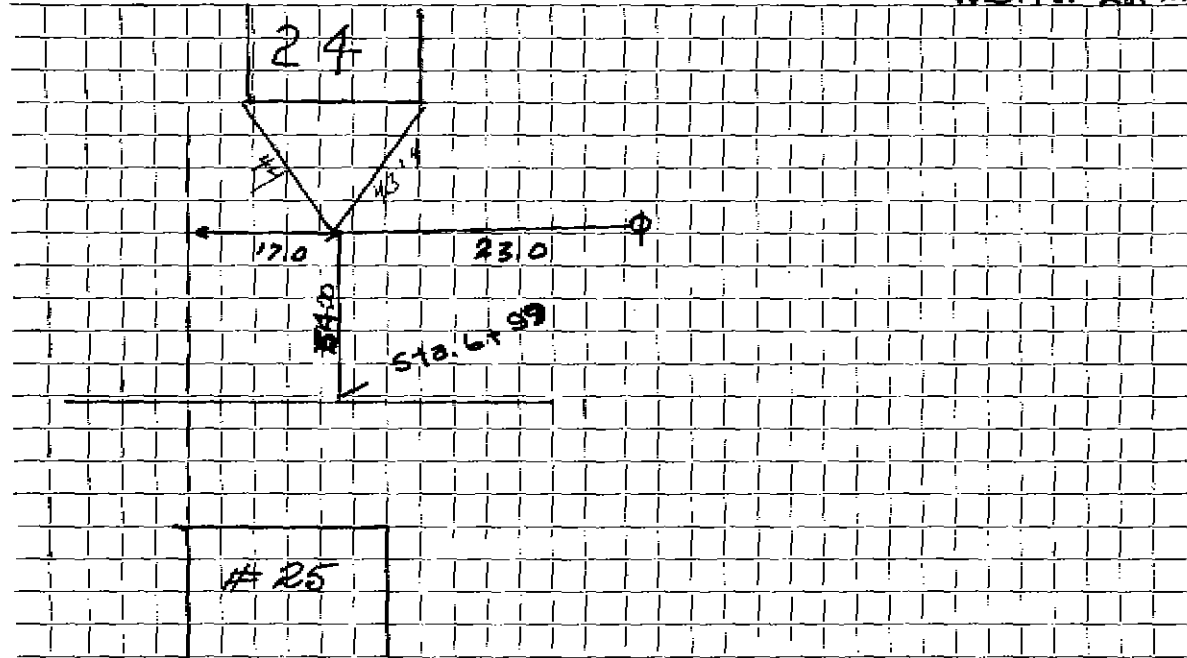

Connection made in Street. Work completed

Remarks:

.....

.....