

WATER SERVICE RECORD

1463
Service No. 150

Name C. Comeau

Address 25 Grapevine Ave.

Location

~~Repair~~ ~~Renewal~~ New Service

Com. 9-6-55


| Date | Material | Amount | Total | Date | Amount |
|---------|-------------------------------------|--------|-------|---------|--------------------------------|
| 7/25/55 | Labor | 1 85 | | 5-27-55 | Deposited |
| | 10% overhead | 19 | 2 04 | 9-6-55 | Refunded |
| | 46'-3/4" copper tubing @ .384 | 17 66 | | | NON CHARGE |
| | 1-3/4" C x 1/2" I.W.H. stop & waste | 4 00 | | 7/25/55 | Labor |
| | 1 hr. trucking @ .75 | | 75 | | 4'-3/4" C copper tubing @ .384 |
| | | | 24 45 | | 1 box and rod |
| | | | | | 1-3/4" C x 3/4" curb-cock |
| | | | | | 1-3/4" C corp-cock |
| | | | | | 1-3/8" straight tail piece |
| | | | | | 1-3/8" offset tail piece |
| | | | | | 17 29 |

DATE _____

TOWN OF LEXINGTON — BOARD OF PUBLIC WORKS

WATER DIVISION

Sketch of Service Here

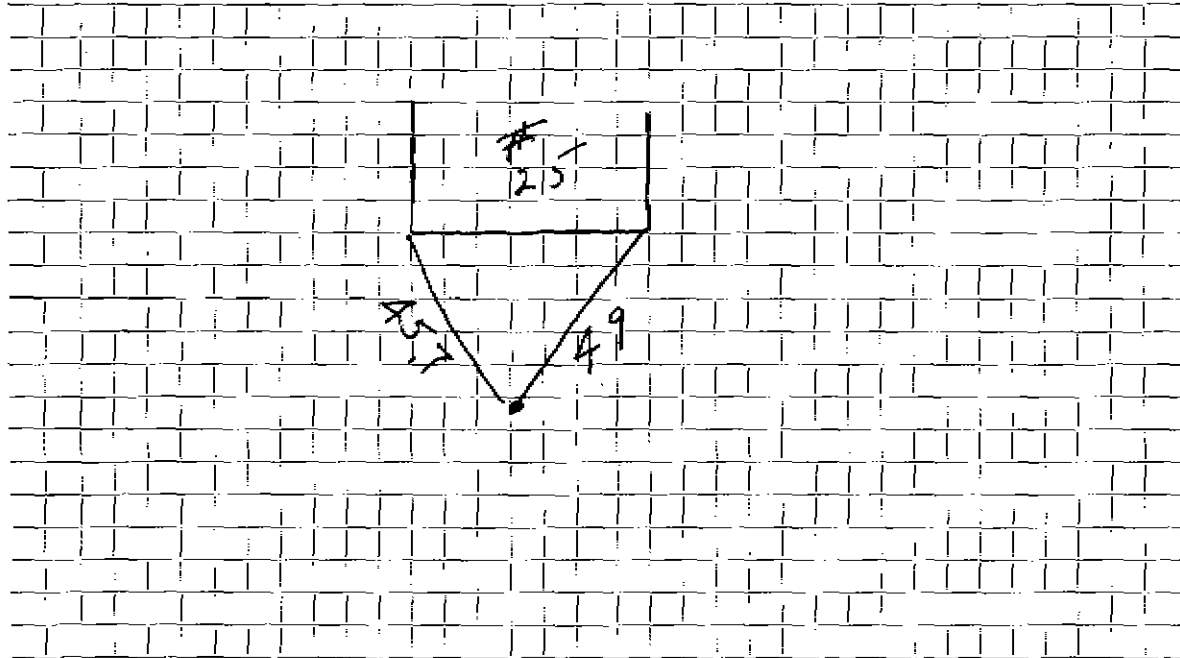

Connection made in Street. Work completed

Remarks:

.....

.....