

WATER SERVICE RECORD

Name

Service No.

Address

Location 29 GRAPEVINE AVE

Repair—Renewal—New Service


Date	Material	Amount	Total	Date	OUT	Amount
	INSIDE 1" IRON				13' 3/4 COPPER	
8-17-98	31' 1" COPPER 1" VALVE					
				7/1/98	1 6X7360 CLAMP TAPED 1"	
					1 1" COPP	
					2' 1" COPPER	
					1 1" X 3/4 UNION	

DATE _____

TOWN OF LEXINGTON — BOARD OF PUBLIC WORKS

WATER DIVISION

Sketch of Service Here

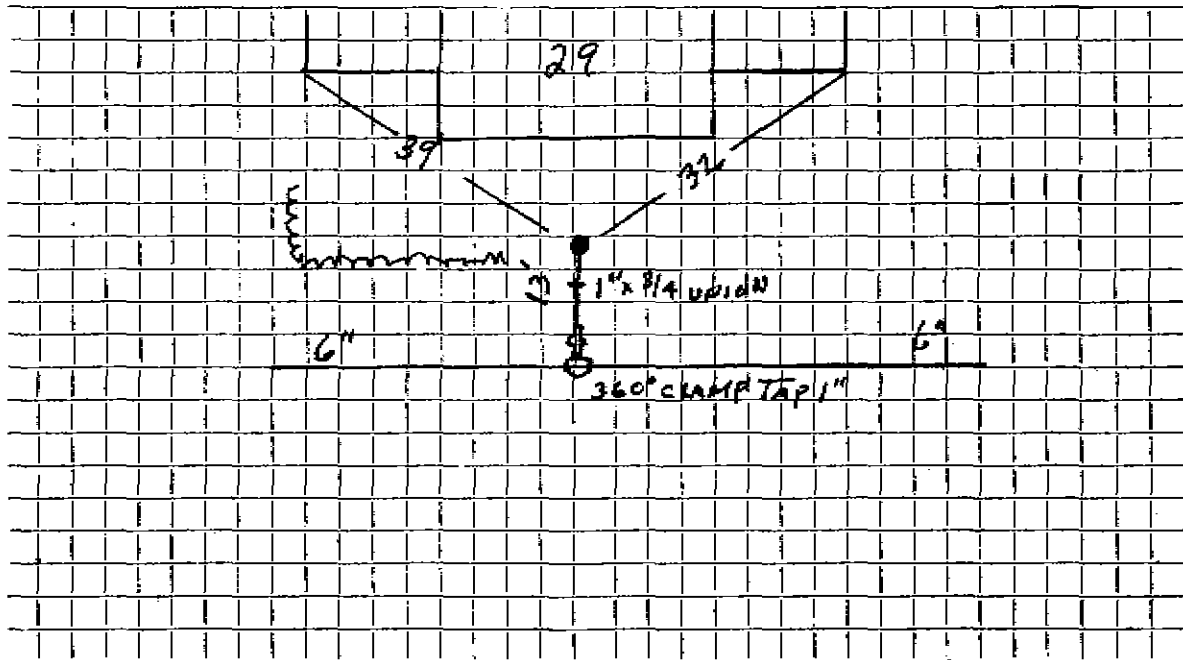

Connection made in Street. Work completed

Remarks:
.....
.....