

WATER SERVICE RECORD

Name Esco Builders Corp.

Service No. 109

Address 30 Grapevine Avenue

Location Lot 29

~~Repair Order~~—New Service W.O. #8222

Comm 2-10-64


Date	Material	Amount	Total	Date	Amount
10/7/63	Labor	2 42		10-2-63	35 00
	10% O.H.	24	2 66	2-10-64	6 85
46'	3/4" Copper Tubing @ .42		19 32		28 15
1	3/4" Cx 1/2 I.W.H. Stop & Waste		6 17		
			28 15	1957	
				33'	3/4" Copper tubing 12.37
				1	3/4" Corp Cock 4.64
				1	3/4" C Curb Cock 5.94
				1	Box & Rod 4.62
					Service installed by contractor 27.57
				10/7/63	1 1/2 Straight Tailpiece 50
					1 1/2 Offset Tailpiece 50
					28 57

DATE _____

TOWN OF LEXINGTON — BOARD OF PUBLIC WORKS

WATER DIVISION

Sketch of Service Here

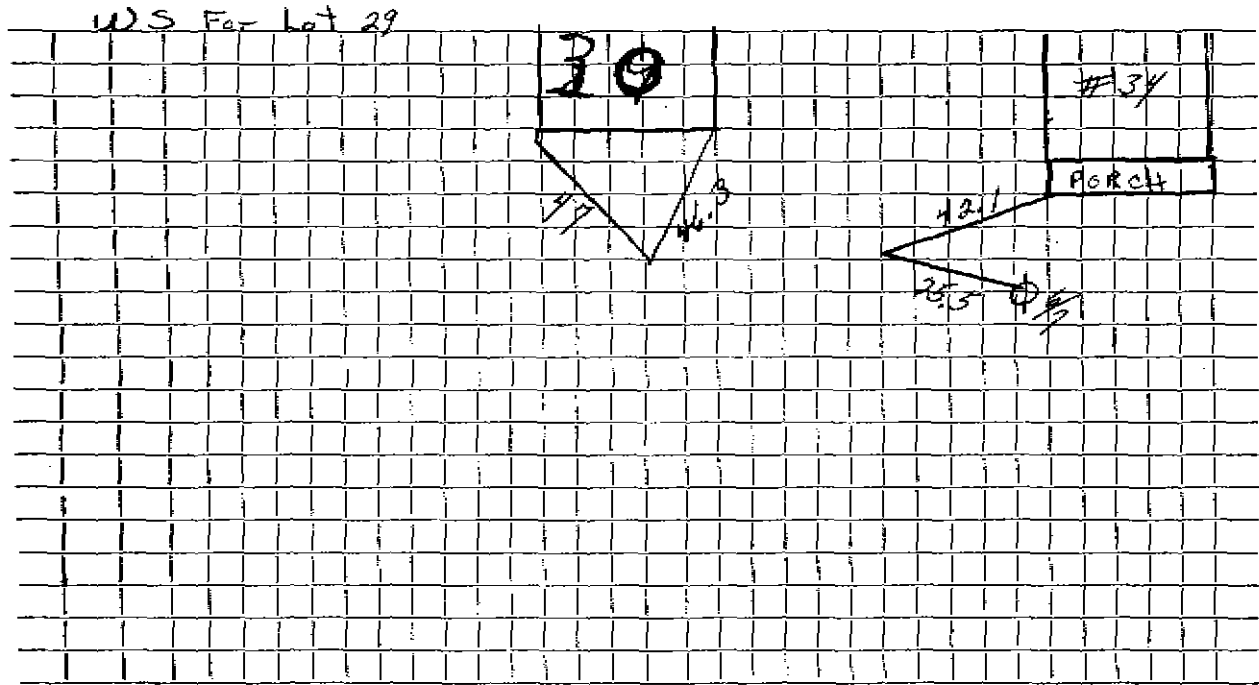

Connection made in Street. Work completed

Remarks:
.
.