

WATER SERVICE RECORD

Name Guy Franceschelli

Service No. 77

Address 34 Grapevine Avenue (pit) - by House #42

Location Lexington

Repair - Renewal - New Service

Sum 6-16-52

Date	Material	Amount	Total	Date	Amount
5/12/52	Labor	20 00		5-1-52 Deposited	50 00
	10% overhead	2 00	22 00	6-16-52 Refunded	(1 25
	Dacey		12 00		NON CHARGE
	2 hrs. Littlefield shovel		14 00	5/9/52 Labor	60 61
	1 hr. trucking		75	5/12/52 "	5 52
			48 75	40' - 1" copper tubing @ .4048	16 19
				20' 2" C.I. pipe @ .82	16 40
				4 - 1" C. corp-cock @ 5.61	22 44
				1 - 2" T.H. gate valve	12 50
				1 - 2" I x 1" C. 4 way branch	19 38
				1 - gate box	14 25
				1 pit cover and frame	8 71
				4 hrs. Littlefield shovel	28 00
				1 hr. trucking	75
					204 75


TOWN OF LEXINGTON — BOARD OF PUBLIC WORKS

WATER DIVISION

Sketch of Service Here

FOR THE FARM

42

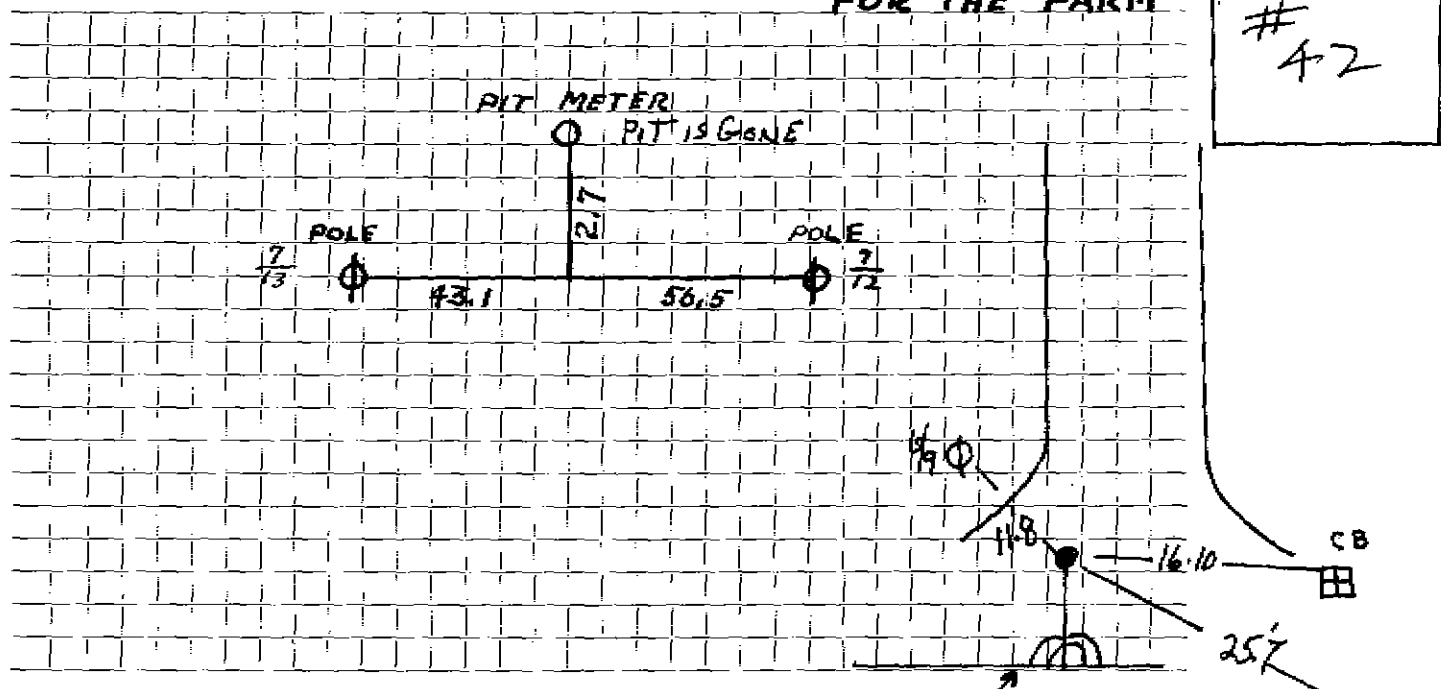

Connection made in Street.

Work completed *This service is alive 12-15-93*

Remarks: *This is same service. Pole no's may have changed? Gate Box to be filled in and cemented. 12-15-93*