

DATE _____

TOWN OF LEXINGTON—BOARD OF PUBLIC WORKS

WATER DIVISION

The undersigned applies for a supply of water at No. _____ St. and hereby agrees to comply with the rules and regulations as now, or at any future time, established by the Board of Selectmen.

Am't. of Estimate \$ _____

Owner


Am't. Paid \$ _____

Address

Builder _____

Mckinnon
34 Grape Vine ave

Sketch of Service Here

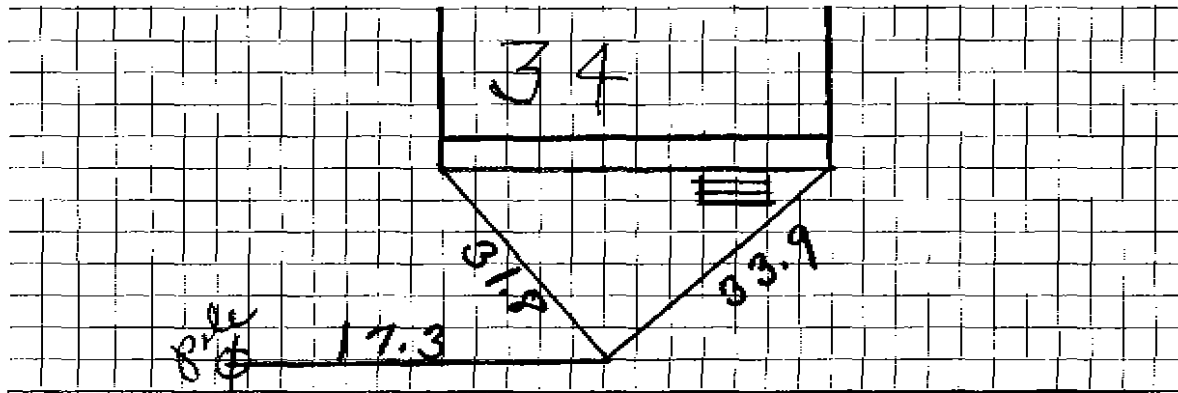

Connection made in Grape Vine Street. ave Work completed _____ 19

Remarks: