

WATER SERVICE RECORD

3521

Name ~~40~~ Donald L. Cruwys

Service No. 120

Address ~~38~~ Grapevine Ave.

Location Lot 33

~~Repair - Renewal~~ New Service Russell Sibley Permit #A 94

MAR 14 1966

Date		Material	Amount	Total	Date		Amount
1965	40'	3/4" Copper tubing			11-16-65	Deposit	31 32
						NON CHARGE	
					1957		
					84' - 3/4"	Copper tubing	16 12
					1 3/4"	Corp Cock	4 64
					1 3/4"	C Curb Cock	5 94
					1	Box & Rod	4 62
							31 32
						Service installed by contractor	


DATE \_\_\_\_\_

TOWN OF LEXINGTON — BOARD OF PUBLIC WORKS

WATER DIVISION

Sketch of Service Here

W.S. For Lot 33

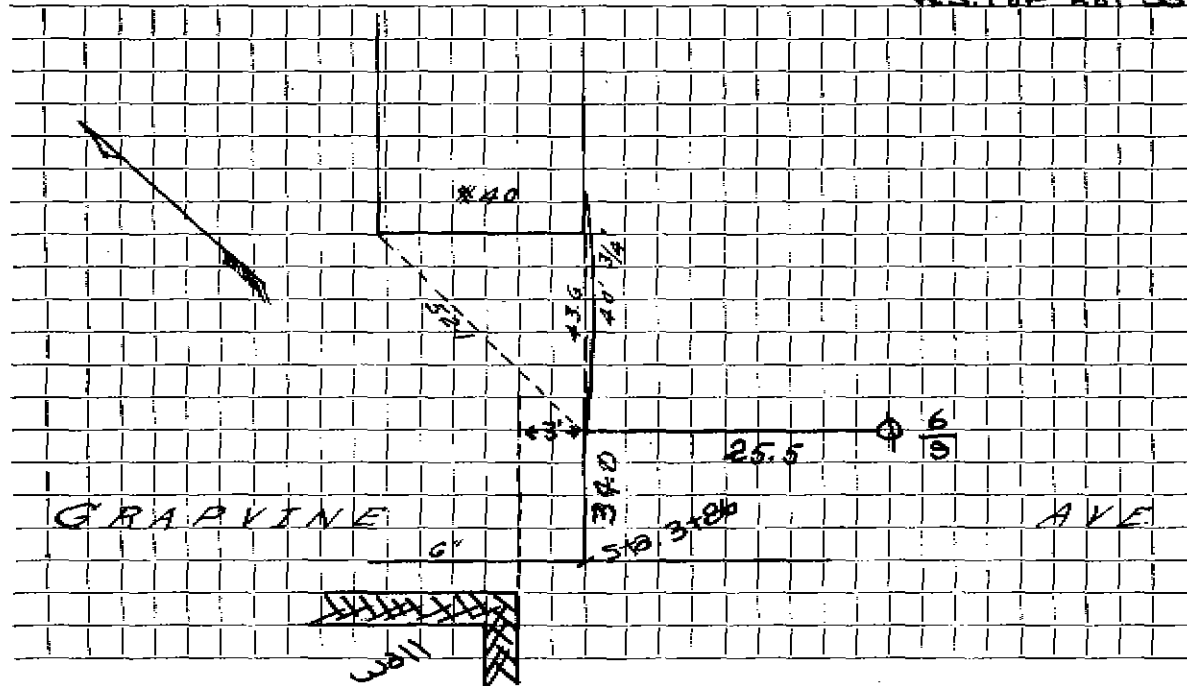

Connection made in ..... Street. Work completed .....

Remarks: .....

.....  
.....