

WATER SERVICE RECORD

4533

Name Donald L. Gruwys

Service No. 121

Address 42 Grapevine Ave.

7250

Location Lot 3A

~~Repair/Reconnect~~ New Service Russell Sibley Permit #A 95

MAR 14 1960

Date		Material	Amount	Total	Date		Amount
12-7-65	45'	3/4" Copper tubing			11/16-65	Deposit	23 82
						NON CHARGE	
					1957		
					32' - 3/4"	Copper tubing	8 62
					1 3/4"	Corp Cock	4 64
					1 3/4"	C Curb Cock	5 94
					1	Box & Rod	4 62
							23 82
						Service installed by contractor	


DATE _____

TOWN OF LEXINGTON — BOARD OF PUBLIC WORKS

WATER DIVISION

Sketch of Service Here

W.S. Form ^{1st} 34

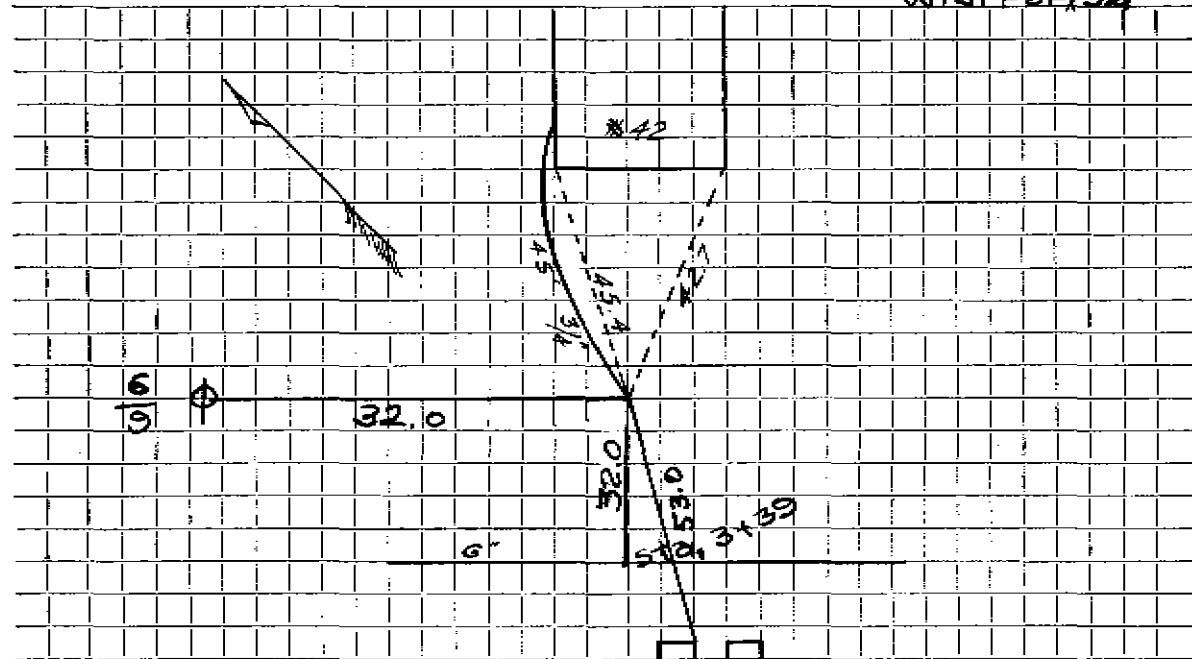

Connection made in Street. W.S. Form 34 completed

Remarks:

.....
.....