




DATE \_\_\_\_\_

TOWN OF LEXINGTON — BOARD OF PUBLIC WORKS

**WATER DIVISION**

Sketch of Service Here

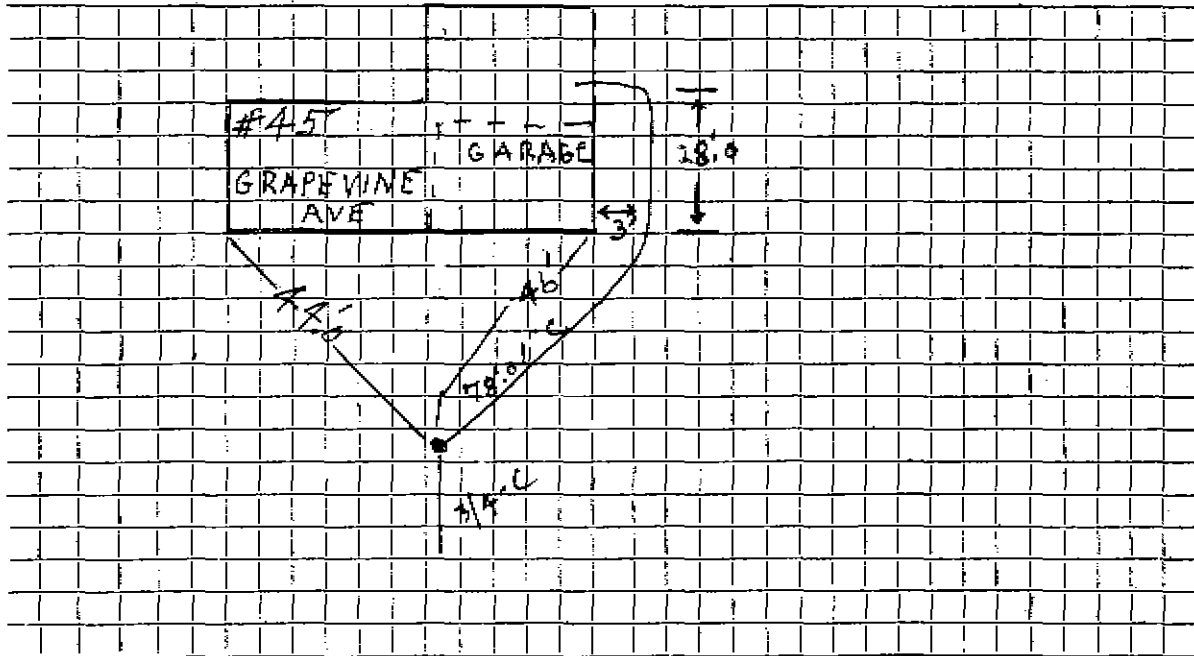

Connection made in ..... Street.

Work completed *A/6/05* *J. McLaughlin*

Remarks: .....  
.....  
.....