

#1765

WATER SERVICE RECORD

Name J. O. D. Construction Co.

Service No. 3

Address 46 Grapevine Ave.

Location Lot 36

~~Repair~~ ~~Renewal~~ ~~New Service~~ Russell Sibley Permit #208


MAY 17 1965

Date		Material	Amount	Total	Date		Amount
3-10-65	41'	3/4" Copper tubing			3-1-65	Deposit	23 82
						NON CHARGE	
					1957		
					32' - 3/4"	Copper Tubing	8 62
					1 3/4"	Corp Cock	1 64
					1 3/4"	G Curb Cock	5 94
					1	Box & Rod	4 62
							23 82
						Service installed by contractor	

DATE _____

TOWN OF LEXINGTON — BOARD OF PUBLIC WORKS
WATER DIVISION

Sketch of Service Here

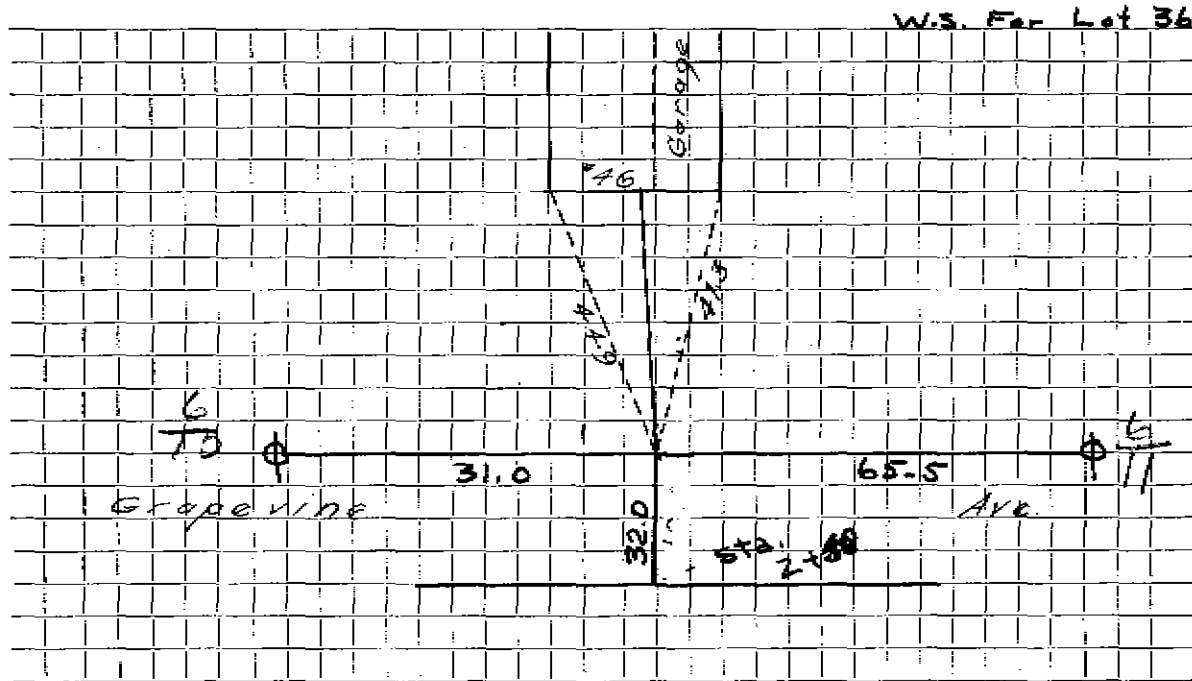

Connection made in Street. Work completed

Remarks:
.....
.....